IREDELL COUNTY HEALTH DEPARTMENT

STATESVILLE 704-878-5305 MOORESVILLE 704-664-5281

IMPROVEMENT PERMIT / AUTHORIZATION TO CONSTRUCT / OPERATION PERMIT / EXISTING SYSTEM INSPECTION

PERMIT# / PIN# 4769-74-1505 DATE 3-30-04

OWNER OR CONTRACTOR PAUL HARMON PHONE: Business Home 704-592-2935

ADDRESS 1618 FRIENDSHIP ROAD STATESVILLE NC 28625

LOCATION 21 N, (L) TABOR (L) TABOR INN MHPOT #4 ON RT

SUBDIVISION TABOR INN MHP BLOCK / SECTION LOT 4 LOT AREA SITE CLASS. DESIGN FLOW 240 L.T.A.R. /

Septic Tank: EXISTING Gallons: STB Date

Pump Tank: Gallons: PT Date

Pump Make: Model Serial No.

Nitrification Field: No Fields Square Feet Linear Feet

No Lines Trench Width Max Trench Bottom Depth Gravel Depth

☐ New System ☒ Repair System Type: I, (II), III, IV, V, VI

System Description: LOW GRAV

Repair System Description:

Maintenance Agreement Required: ☐ Yes ☒ No

☐ House/Mod. Home No. Bedrooms 3

☒ Mobile Home No. Bathrooms 2

☐ Business No. Employees

☐ Other

☐ Slab ☒ Crawl Space ☐ Basement w/plumbing ☐ Basement wo/plumbing


Water Supply: ☐ Individual ☒ Public ☐ Community

Comments:/Conditions: (1) REPLACE COLLAPSED SUPPLY LINE & INSTALL NEW BOX AS DRAWN


(2) LOT # 3 IS VACANT AT TIME OF CHECK. IT SHARED A SYSTEM WITH LOT 4

Comments:/Conditions: INSTALLED NEW TEE" THIS PERMIT SERVES AS NOTICE OF VIOLATION AND MUST BE REPAIRED WITHIN 30 DAYS.

INITIAL SITE SKETCH

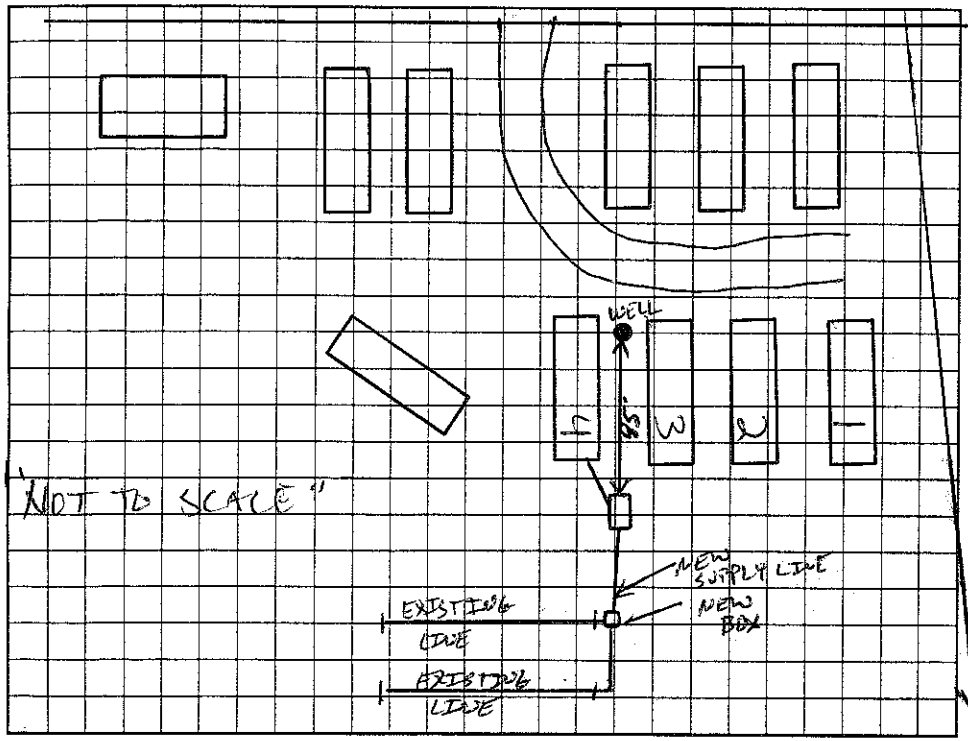

AS BUILT SKETCH

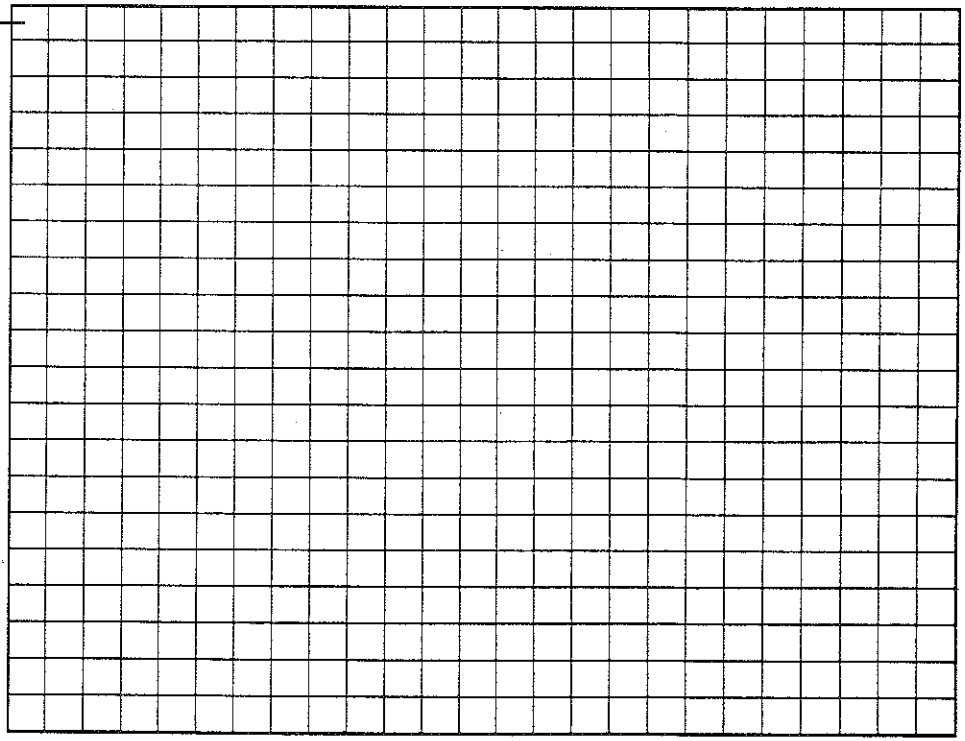

Permit can be suspended or revoked if any false information is supplied toward securing the permit/any unauthorized changes are made to the site/any unauthorized changes are made in the installation of the system. Improvement Permit with plat valid without expiration. Improvement Permit with site plan valid for sixty months. Authorization to Construct is valid for a period equal to that of Improvement Permit – not to exceed sixty months.

Signed: Paul Harmon date 3-31-04 Installed by: JEFF HURLBERT

Improvement Permit by: date 3-30-04 Operation Permit by: date 3-30-04

Authorization to Construct by: date 3-30-04 Existing System Inspection by: date

HEALTH DEPT. COPY: WHITE OWNER COPY (FINAL): YELLOW OWNER COPY (INITIAL): PINK