58235

IREDELL COUNTY HEALTH DEPARTMENT

STATESVILLE 704-878-5305 MOORESVILLE 704-664-5281

IMPROVEMENT PERMIT / CERTIFICATE OF COMPLETION / OPERATION PERMIT / EXISTING SYSTEM INSPECTION

PROPERTY DESCRIPTION NO. 22326 DATE 11-2-95 TAX MAP NO. 126-A-33 Watershed: ☐ Yes ☒ No

OWNER OR CONTRACTOR CLARENCE TURNER PHONE: Business Home 546-7259

ADDRESS 193 NOEL RD HARMONY NC 28634

LOCATION US 21N, TR NOEL RD, MH SITE BEHIND 2ND HOUSE ON LEFT EXISTING

SUBDIVISION BLOCK / SECTION LOT LOT AREA 6.5 AC SITE CLASS. PS DESIGN FLOW 360 L.T.A.R. EXISTING

Septic Tank: EXIST Gallons: STB Date

Pump Tank: Gallons; PT Date

Pump Make: Model Serial No.

Nitrification Field: No Fields Square Feet Linear Feet EXIST

No Lines EXIST Trench Width Max Trench Bottom Depth Gravel Depth

☐ New System ☐ Repair System Type: I ☒ II, IV, V, VI

System Description: CONV. GRAVITY

Repair System Description:

Maintenance Agreement Required: ☐ Yes ☒ No

☐ Slab ☐ Crawl Space ☐ Basement w/plumbing ☐ Basement wo/plumbing

☐ House/Mod. Home No. Bedrooms 3

☒ Mobile Home No. Bathrooms 2

☐ Business No. Employees


☐ Other

Water Supply:
☒ Individual
☐ Community
☐ Public WELL


Comments:

Comments: ① KEEP MH MINIMUM 5' FROM SEPTIC SYSTEM
② NO VEHICULAR TRAFFIC ALLOWED OVER SEPTIC SYSTEM

INITIAL SITE SKETCH

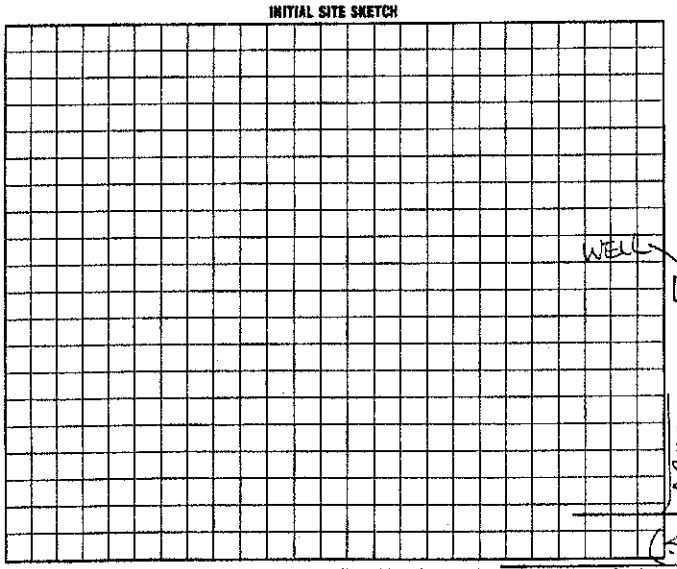

AS BUILT SKETCH

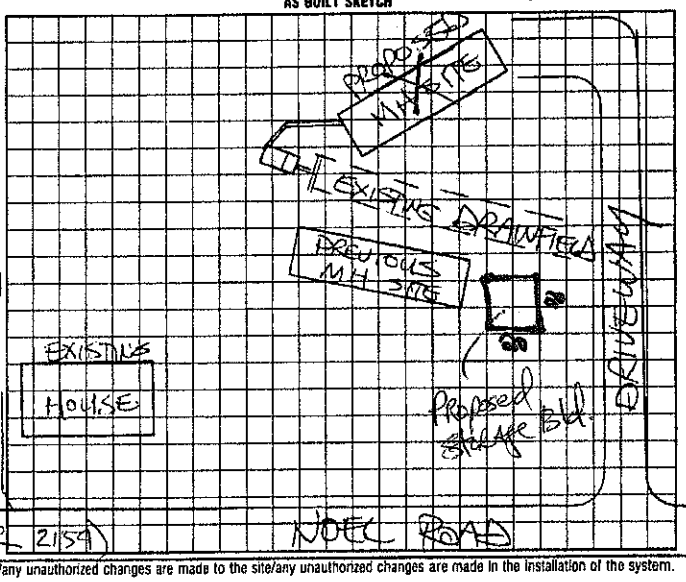

I understand that this permit can be suspended or revoked if any false information is supplied toward securing the permit/any unauthorized changes are made to the site/any unauthorized changes are made in the installation of the system. Improvement Permit is valid for 60 months from date of issuance.

Signed: Installed by:

Improvement Permit by: date Certificate of Completion by: date

Existing System Inspection by: STEVE HEDRICK date 11-2-95 Operation Permit by: date

HEALTH DEPT. COPY: WHITE INSPECTION COPY (FINAL): GREEN OWNER COPY (FINAL): YELLOW INSPECTION COPY (INITIAL): PINK OWNER COPY (INITIAL): GOLD

Location of the proposed Proposed Storage Building addition does not appear to impact the existing on-site septic system.NOTE:**

REHS

Date: 7-5-12

ICHD-Environmental Health Division