IREDELL COUNTY HEALTH DEPARTMENT

STATESVILLE 704-878-5305 MOORESVILLE 704-664-5281

IMPROVEMENT PERMIT / AUTHORIZATION TO CONSTRUCT / OPERATION PERMIT / EXISTING SYSTEM INSPECTION

PERMIT# 07834 PIN# 4769 84 2368 DATE 12-31-98

OWNER OR CONTRACTOR THOMAS CHAMBERS PHONE: Business _____ Home _____

ADDRESS 2967 HARMONY Hwy HARMONY, NC 28634

LOCATION US 21 NORTH, FIRST LOT ON LEFT, PAST TABOR ROAD

SUBDIVISION _____ BLOCK / SECTION _____ LOT _____ LOT AREA 1.00 ACRE SITE CLASS PS DESIGN FLOW 360 L.T.A.R. 0.30 GPD/FT²

Septic Tank: 1000 Gallons; STB 160 Date 5-12-97
Pump Tank: _____ Gallons; PT _____ Date _____
Pump Make: _____ Model _____ Serial No. _____
Nitrification Field: No. Fields 1 Square Feet 1200 Linear Feet 400
No Lines FIVE Trench Width 36" Max Trench Bottom Depth 36" Gravel Depth 12"

[V] New System [ ] Repair System Type: I, II, III, IV, V, VI
System Description: CONVENTIONAL GRAVITY
Repair System Description: CONV. GRAVITY
Maintenance Agreement Required: [ ] Yes [V] No
[ ] Slab [V] Crawl Space [ ] Basement w/plumbing [ ] Basement wo/plumbing


[ ] House/Mod. Home No. Bedrooms 3
[V] Mobile Home No. Bathrooms 2
[ ] Business No. Employees _____
[ ] Other _____

Water Supply: [ ] Individual [V] Public [ ] Community


Comments:/Conditions: NO VEHICULAR TRAFFIC ALLOWED OVER SYSTEM

Comments:/Conditions: SEPTIC TANK

SCALE: 1"=40' INITIAL SITE SKETCH

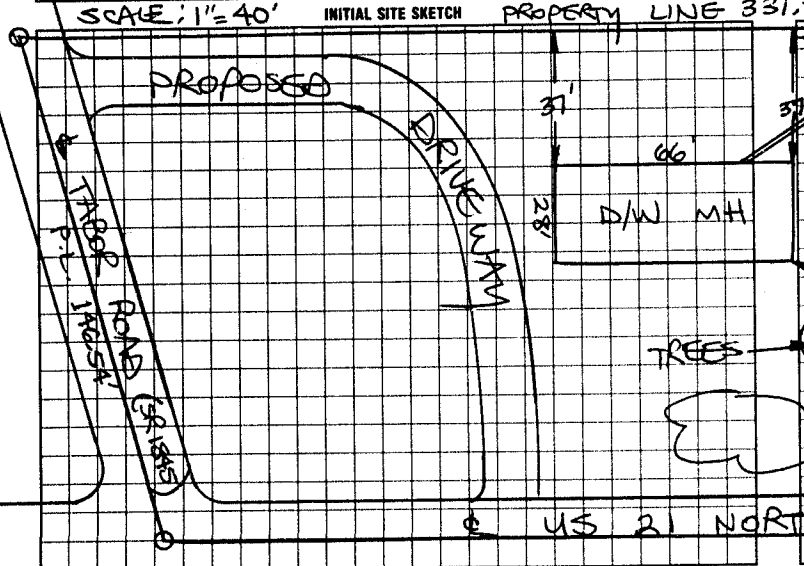

AS BUILT SKETCH

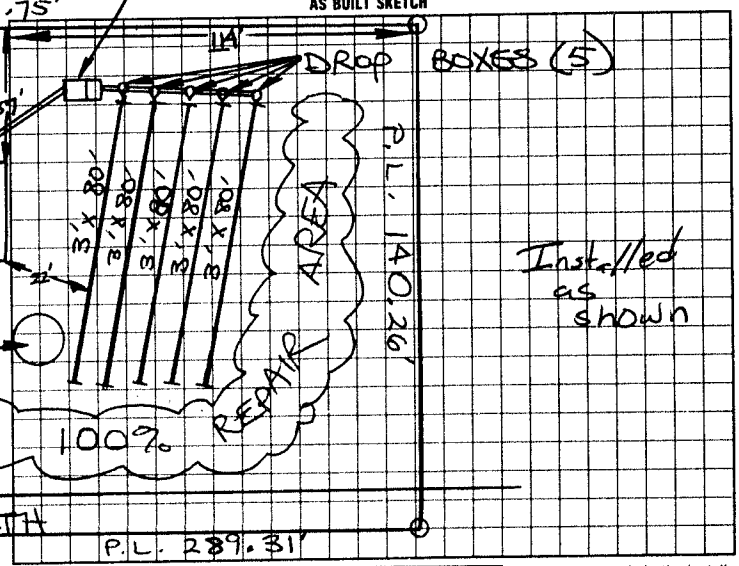

I understand that this permit can be suspended or revoked if any false information is supplied toward securing the permit/any unauthorized changes are made to the site/any unauthorized changes are made in the installation of the system. Improvement Permit with plat valid without expiration. Improvement Permit with site plan valid for sixty months. Authorization to Construct is valid for a period equal to that of Improvement Permit – not to exceed sixty months.

Signed: Thomas D. Chambers date 1-19-99 Installed by: Hickory Backhoe

Improvement Permit by: STEVE HEARICK date 12-31-98 Operation Permit by: [signature] date 6-29-99

Authorization to Construct by: STEVE HEARICK date 12-31-98 Existing System Inspection by: _____ date _____

HEALTH DEPT. COPY: WHITE INSPECTION COPY (FINAL): GREEN OWNER COPY (FINAL): YELLOW INSPECTION COPY (INITIAL): PINK OWNER COPY (INITIAL): GOLD