# IREDELL COUNTY HEALTH DEPARTMENT

STATESVILLE 704-878-5305 MOORESVILLE 704-664-5281

## IMPROVEMENT PERMIT / CERTIFICATE OF COMPLETION / OPERATION PERMIT / EXISTING SYSTEM INSPECTION

PROPERTY DESCRIPTION NO. 68489 DATE 7-31-97 TAX MAP NO. 4769 93 7995 Watershed: ☐ Yes ☐ No

OWNER OR CONTRACTOR Mark A. Wellman PHONE: Business Home

ADDRESS 642 Jane Sowers Rd

LOCATION US 21 N TR Chief Thomas RJ Sta. 1/8 mi left

SUBDIVISION BLOCK / SECTION LOT LOT AREA 6 acres SITE CLASS. PS DESIGN FLOW 360 L.T.A.R. .3

Septic Tank: 1000 Gallons; STB 1012 Date 8-10-98
Pump Tank: Gallons; PT Date
Pump Make: Model Serial No.
Nitrification Field: No Fields 1 Square Feet 1600 Linear Feet 533
No Lines 4 Trench Width 36" Max Trench Bottom Depth 36" Gravel Depth 12"

☐ New System ☐ Repair System Type: ☐ I ☐ II ☐ III, IV, V, VI
System Description: Conv. Gravity
Repair System Description: " "
Maintenance Agreement Required: ☐ Yes ☒ No


☒ House/Mod. Home No. Bedrooms 4
☐ Mobile Home No. Bathrooms 2½
☐ Business No. Employees
☐ Other
☐ Slab ☐ Crawl Space ☐ Basement w/plumbing ☒ Basement wo/plumbing

Water Supply: ☐ Individual ☐ Community ☒ Public


Comments:

Comments:

INITIAL SITE SKETCH

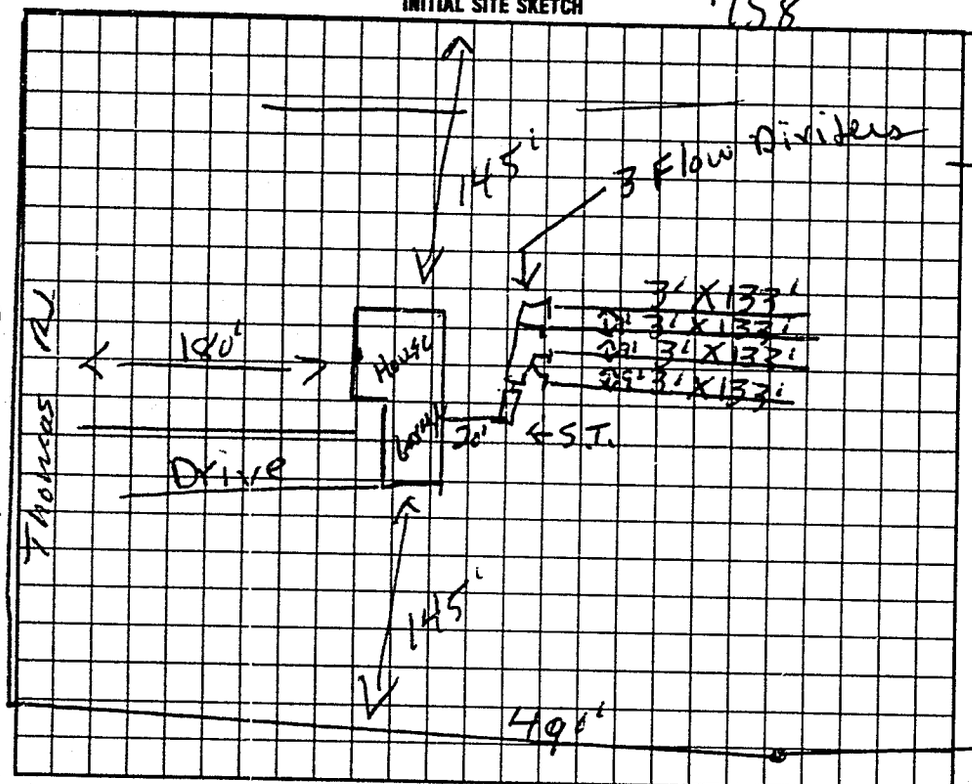


AS BUILT SKETCH

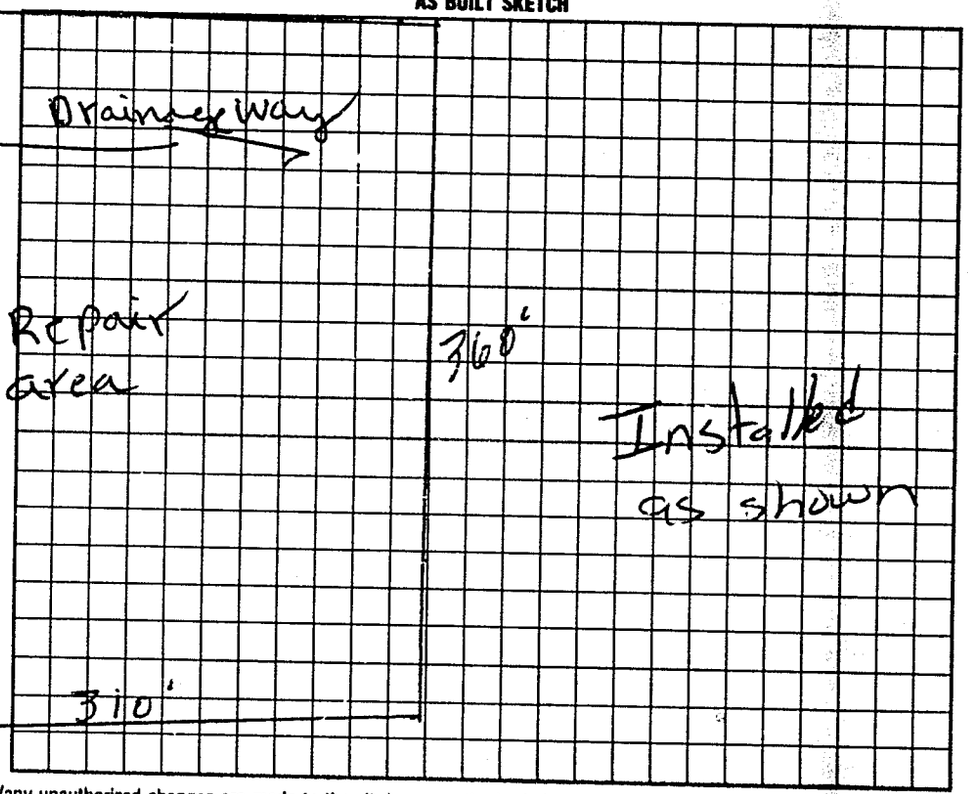


Chief 360'

I understand that this permit can be suspended or revoked if any false information is supplied toward securing the permit/any unauthorized changes are made to the site/any unauthorized changes are made in the installation of the system. Improvement Permit is valid for 60 months from date of issuance.

Signed: Mark A. Wellman, by David Montgomery, Agent

Improvement Permit by: L.C. Moore date 7-31-97

~~Existing System Inspection~~ Authorization by: L.C. Moore date 7-31-97

to cont.

Installed by: David Yountz

Certificate of Completion by: date

Operation Permit by: Mark C. Ayers date 10-16-98

HEALTH DEPT. COPY: WHITE INSPECTION COPY (FINAL): GREEN OWNER COPY (FINAL): YELLOW INSPECTION COPY (INITIAL): PINK OWNER COPY (INITIAL): GOLD

Authorization to cont Expires 60 mos from issue