IREDELL COUNTY HEALTH DEPARTMENT

Statesville Office (704) 878-5305 Mooresville Office (704) 660-3625 PERMIT # 226174

IMPROVEMENT PERMIT / AUTHORIZATION TO CONSTRUCT / OPERATION PERMIT / EXISTING SYSTEM

PIN # 4769950566

APPLICANT: Juan Ramirez APPLICANT ADDRESS: 2647 Harmony Hwy Harmony NC

SITE ADDRESS: 2647 Harmony Hwy - Harmony NC PHONE: 704-698-7878 ALT. PHONE: n/a


SITE DIRECTIONS: 77 N T/R 21 Lot on left before Harmony

SUBDIVISION: 21 Acres SECTION: 7A LOT # 8 LOT AREA: 1.150 ac. DESIGN FLOW: 360 L.T.A.R.: Ey


Septic Tank	Ey	(gal)	STB		Date		☐ New System	☐ Repair	☐ Expansion	System Type: I	II	III IV V VI	☒ Residence	No. Bedrooms	3	Water Supply	
Pump Tank		(gal)	PT		Date		System Description:	Existing					☐ Business	No. Persons	6	☐ Private	
Pump Make		Model			Serial #		Repair System Description:						☐ Other	No. Employees		☒ Public	
# Nitrification Fields	Ey	# Lines	Ey		Linear Ft:	Ey	Maintenance Agreement Required:	☐ YES	☒ NO				☐ Slab	☒ Crawl Space		☐ Community	
Trench Width	Ey	Max. Trench Bottom Depth		Ey	Gravel Depth	Ey	☒ GRAVITY	☐ PRESSURE					☐ Basement w/plumbing			☐ Basement w/o plumbing	

Comments / Conditions: All parts of STS must be 35' from any part of addition

INITIAL SITE SKETCH

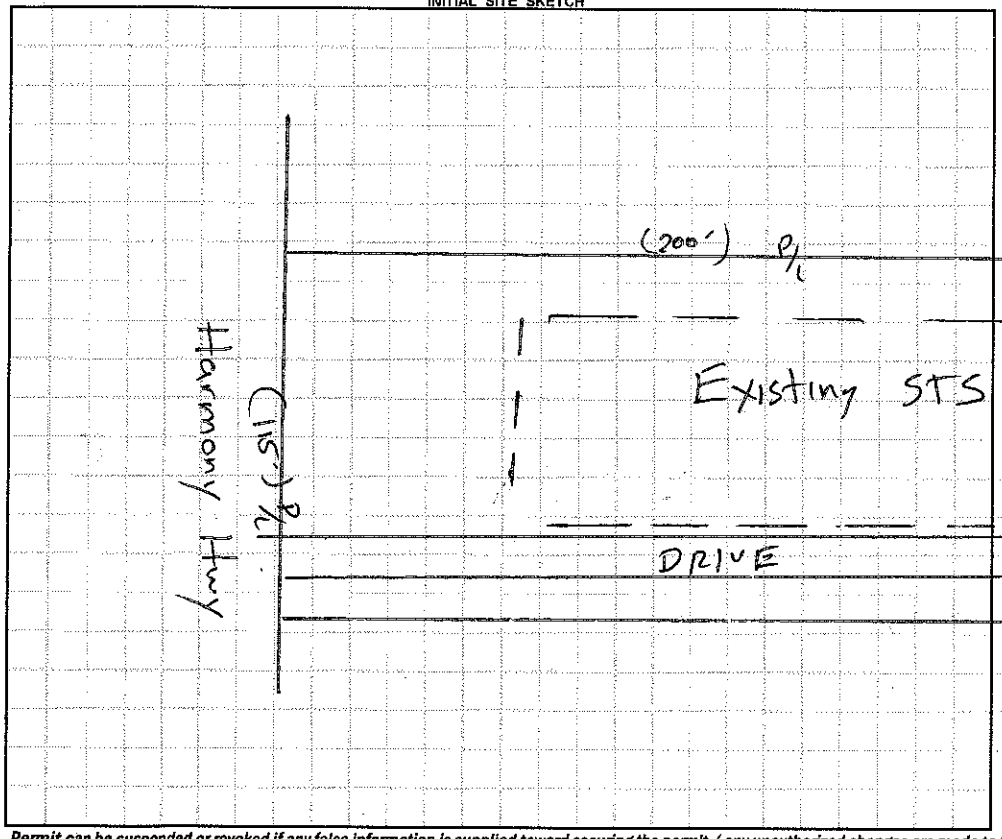

AS BUILT SKETCH

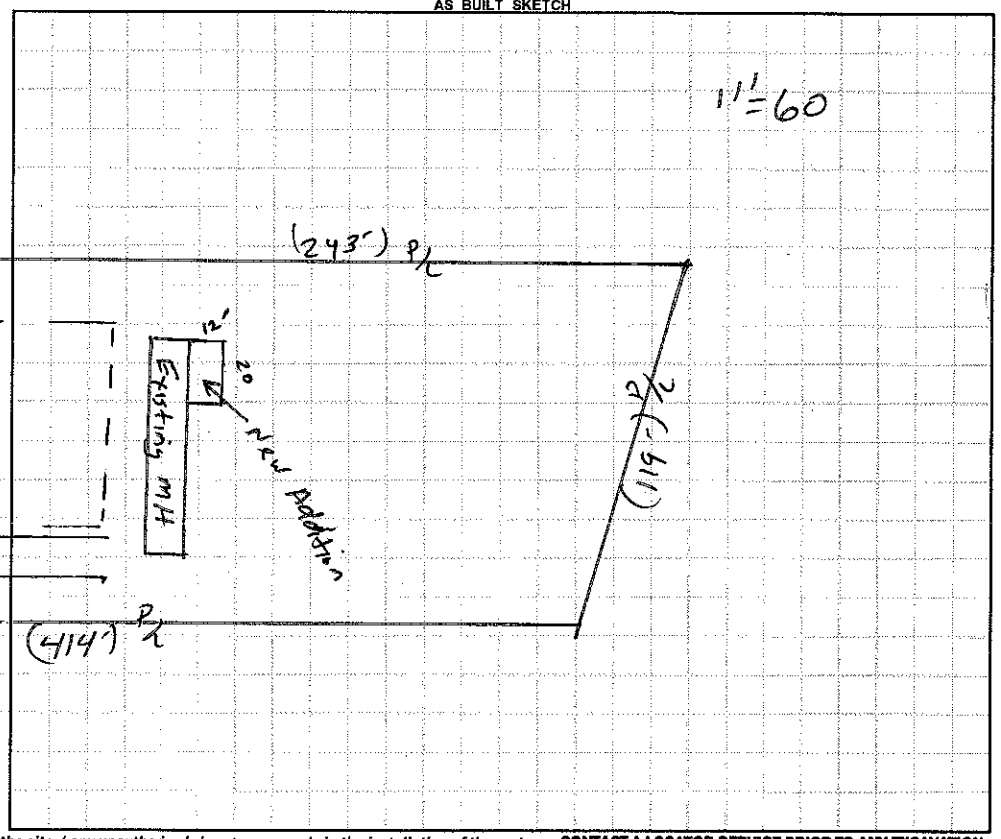

Permit can be suspended or revoked if any false information is supplied toward securing the permit / any unauthorized changes are made to the site / any unauthorized changes are made in the installation of the system. **CONTACT A LOCATOR SERVICE PRIOR TO ANY EXCAVATION**

☐ **IMPROVEMENT PERMIT** ***with plat*** *valid without expiration.* ☐ **IMPROVEMENT PERMIT** ***with site plan*** *valid for 60 mos.* ☐ **AUTHORIZATION TO CONSTRUCT** *valid for period equal to IMPROVEMENT PERMIT--not to exceed 60 mo.*

Owner / Applicant Signature: Juan Ramirez Date: 5-2-17 Installed by:

IMPROVEMENT PERMIT by: Date: OPERATION PERMIT by: Date:

AUTHORIZATION TO CONSTRUCT by: Date: Existing System Inspected by: Date: 05/02/17

Health Dept. Copy - WHITE Applicant (Final Approval) - YELLOW Applicant (Conditional Approval) - PINK