IREDELL COUNTY HEALTH DEPARTMENT

Authorization to Const. 64468

STATESVILLE 704-878-5305 MOORESVILLE 704-664-5281

IMPROVEMENT PERMIT / CERTIFICATE OF COMPLETION / OPERATION PERMIT / EXISTING SYSTEM INSPECTION

PROPERTY DESCRIPTION NO. 25416 DATE 11-5-96 TAX MAP NO. 126 2 A 10 (pt) Watershed: ☐ Yes ☒ No

OWNER OR CONTRACTOR Daniel Smith PHONE: Business Home 546-5116

ADDRESS PO Box 70 Harmony 28634

LOCATION Hwy 21 N on left past Chief Thomson Rd

SUBDIVISION BLOCK / SECTION LOT LOT AREA SITE CLASS. P/S DESIGN FLOW 240 L.T.A.R. 0.32

Septic Tank: 1000 Gallons; STB 620 Date 11-5-96

Pump Tank: Gallons; PT Date

Pump Make: Model Serial No.

Nitrification Field: No Fields 1 Square Feet 750 Linear Feet 250

No Lines 3 Trench Width 36 Max Trench Bottom Depth 30 Gravel Depth 12

☒ New System ☐ Repair -System Type: I, (II) III, IV, V, VI

System Description: Gravity Conventional

Repair System Description: Carlon Pump / Convent.

Maintenance Agreement Required: ☐ Yes ☒ No

☐ House/Mod. Home No. Bedrooms 2

☒ Mobile Home No. Bathrooms 2

☐ Business No. Employees

☐ Other


☐ Slab ☒ Crawl Space ☐ Basement w/plumbing ☐ Basement wo/plumbing

Water Supply: ☐ Individual ☐ Community ☒ Public


Comments: Keep Lines on Contour, 4' on center, keep Trenches 30in Land Scape to prevent water - Continue Drainage Ditch

Comments: NO VEHICULAR TRAFFIC ALLOWED OVER DRAINFIELD

INITIAL SITE SKETCH

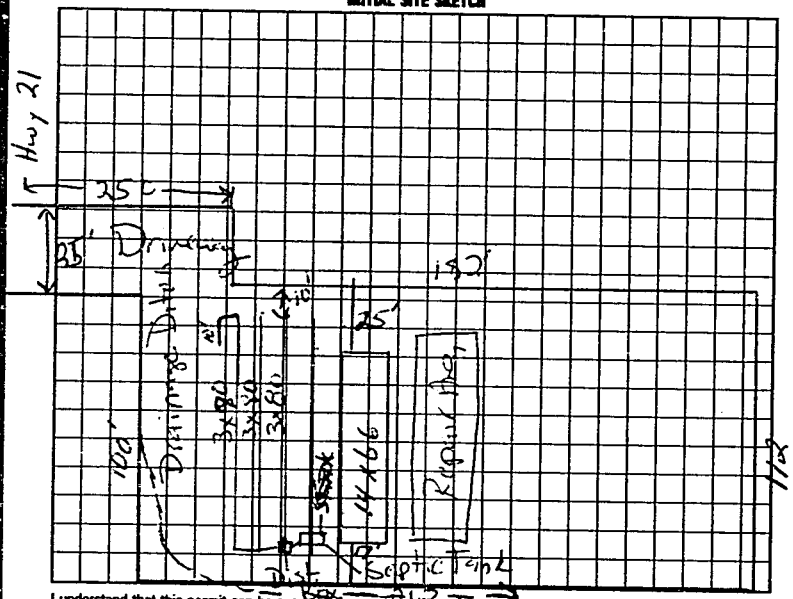

AS BUILT SKETCH

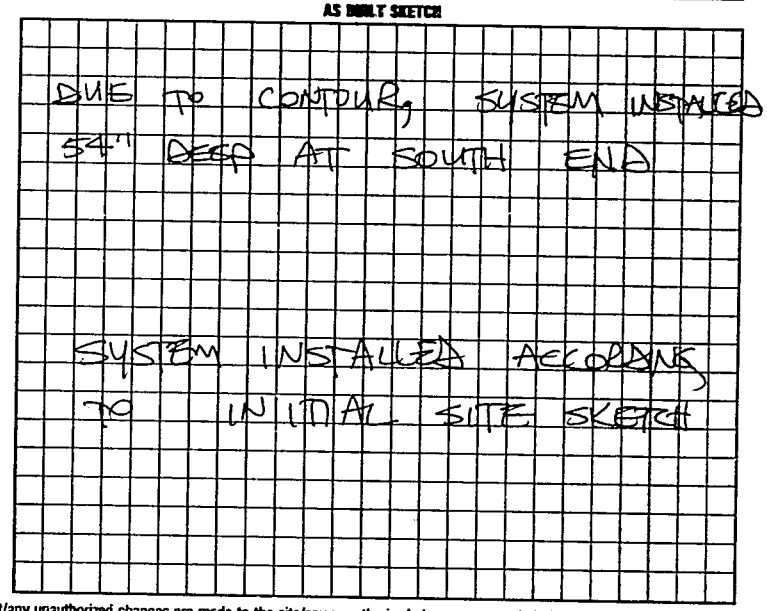

I understand that this permit can be suspended or revoked if any false information is supplied toward securing the permit/any unauthorized changes are made to the site/any unauthorized changes are made in the installation of the system.

Authorization to Const. expires 5yrs at my date of issue

Signed: X Stanley Smith

Improvement Permit by: J. Mark Cox RS date 11-5-96

Authorization to Const. by: J. Mark Cox RS date 11-5-96

Existing System Inspection by:

Installed by: SAMMY REAVIS

Certificate of Completion by: date

Operation Permit by: STEVE HEDRICK date 12-11-96

HEALTH DEPT. COPY: WHITE INSPECTION COPY (FINAL): GREEN OWNER COPY (FINAL): YELLOW INSPECTION COPY (INITIAL): PINK OWNER COPY (INITIAL): GOLD