9:30

IREDELL COUNTY HEALTH DEPARTMENT

STATESVILLE 704-878-5305 MOORESVILLE 704-664-5281

IMPROVEMENT PERMIT / AUTHORIZATION TO CONSTRUCT / OPERATION PERMIT / EXISTING SYSTEM INSPECTION

PERMIT# 076865 PIN# 477002 4925 DATE 5-13-99

OWNER OR CONTRACTOR Edward Campbell PHONE: Business 664-7574 Home

ADDRESS 821 Mallard Place Mooresville, NC 28115

LOCATION Shinnville Rd on Left B4 Perry Park Ln - From M'ville Shinnville Rd just before creek - Clod

SUBDIVISION BLOCK / SECTION LOT LOT AREA 1.80 Acre SITE CLASS. PS DESIGN FLOW 360 gpd L.T.A.R. .3

Septic Tank: 1000 Gallons; STB 794 Date 2/24/99
Pump Tank: Gallons; PT Date
Pump Make: Model Serial No.
Nitrification Field: No Fields 1 Square Feet 900' Linear Feet 300'
No Lines 4 at 75' Trench Width 36" Max Trench Bottom Depth 36" Gravel Depth N/A


☒ New System ☐ Repair System Type: I, II, III, IV, V, VI
System Description: Gravity - 25% Reduction
Repair System Description: Pumped.
Maintenance Agreement Required: ☐ Yes ☒ No

☒ House/Mod. Home ☐ Mobile Home ☐ Business ☐ Other
No. Bedrooms 3 No. Bathrooms 2 No. Employees
☐ Slab ☐ Crawl Space ☒ Basement w/plumbing ☐ Basement wo/plumbing

Water Supply: ☒ Individual ☐ Public ☐ Community

Comments:/Conditions: 25% Reduction in Drainfield area
Keep Septic System 15' from gullies/Drainageways unless properly filled then 5ft. Drainlines extend off property onto area deededas "Septic Drainfield Easement." (Owner will "Stub-in" basement plumbing but will use "grinder pump" for basement. Deed of Easement attached.

INITIAL SITE SKETCH Scale 1:100

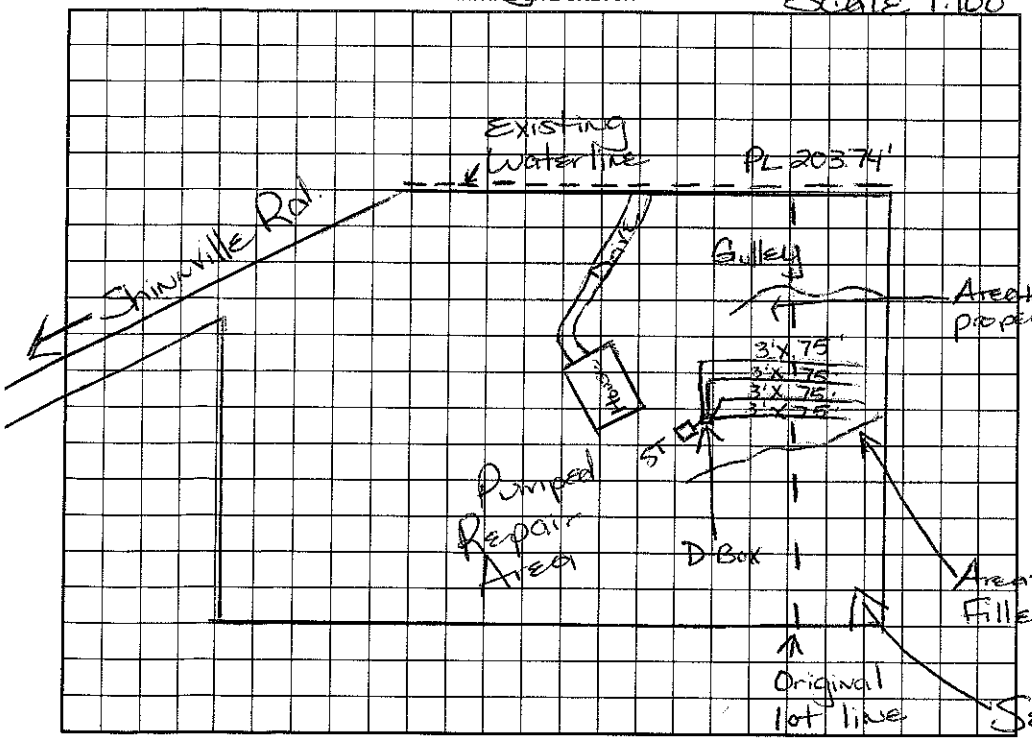

AS BUILT SKETCH

Permit can be suspended or revoked if any false information is supplied toward securing the permit/any unauthorized changes are made to the site/any unauthorized changes are made in the installation of the system. Improvement Permit with plat valid without expiration. Improvement Permit with site plan valid for sixty months. Authorization to Construct is valid for a period equal to that of Improvement Permit – not to exceed sixty months.

Signed: date

Improvement Permit by: Maria H. Dotson date 5/14/99

Authorization to Construct by: Maria H. Dotson date 5/14/99

Installed by: Larry Beam Grading

Operation Permit by: Jeff Mayer date 5/21/99

Existing System Inspection by: date

HEALTH DEPT. COPY: WHITE OWNER COPY (FINAL): YELLOW OWNER COPY (INITIAL): PINK