IREDELL COUNTY HEALTH DEPARTMENT

STATESVILLE 704-878-5305 MOORESVILLE 704-664-5281

IMPROVEMENT PERMIT / AUTHORIZATION TO CONSTRUCT / OPERATION PERMIT / EXISTING SYSTEM INSPECTION

$125.00 Paid

PERMIT# 102680 ZO PIN# 4776030544 Matt Garrett DATE 9/26/2001

OWNER OR CONTRACTOR Kathy Barringer PHONE: Business 528-0848 Home

ADDRESS 1163 Shinnville Rd Cleveland, NC 27013

LOCATION Hwy 21 TR Shinnville Rd just before

SUBDIVISION BLOCK / SECTION LOT LOT AREA .56 Acre SITE CLASS. PS DESIGN FLOW 360 gpd L.T.A.R. .325

Septic Tank: Existing Gallons: STB Date

Pump Tank: Gallons: PT Date

Pump Make: Model Serial No.

Nitrification Field: No Fields 1 Square Feet 300' Linear Feet 100'

No Lines 1 Trench Width 36" Max Trench Bottom Depth 3" Gravel Depth 12"

☐ New System ☐ Repair System Type: I, II, III, IV, V, VI

System Description: Addition Gravity - Conventional

Repair System Description: Modified

Maintenance Agreement Required: ☐ Yes ☒ No

☐ House/Mod. Home ☒ Mobile Home ☐ Business ☐ Other

No. Bedrooms 3 No. Bathrooms 2 No. Employees


☐ Slab ☒ Crawl Space ☐ Basement w/plumbing ☐ Basement wo/plumbing

Water Supply: ☒ Individual on ☐ Public adjacent lot ☐ Community


Comments:/Conditions: Install 1-additional Drainline 3'X100', add onto drainline closest to MH. (Existing Septic System appears to be Functioning Okay at time of inspection

Comments:/Conditions: Upgrading from 2 bedroom to 3 Bedroom.

INITIAL SITE SKETCH

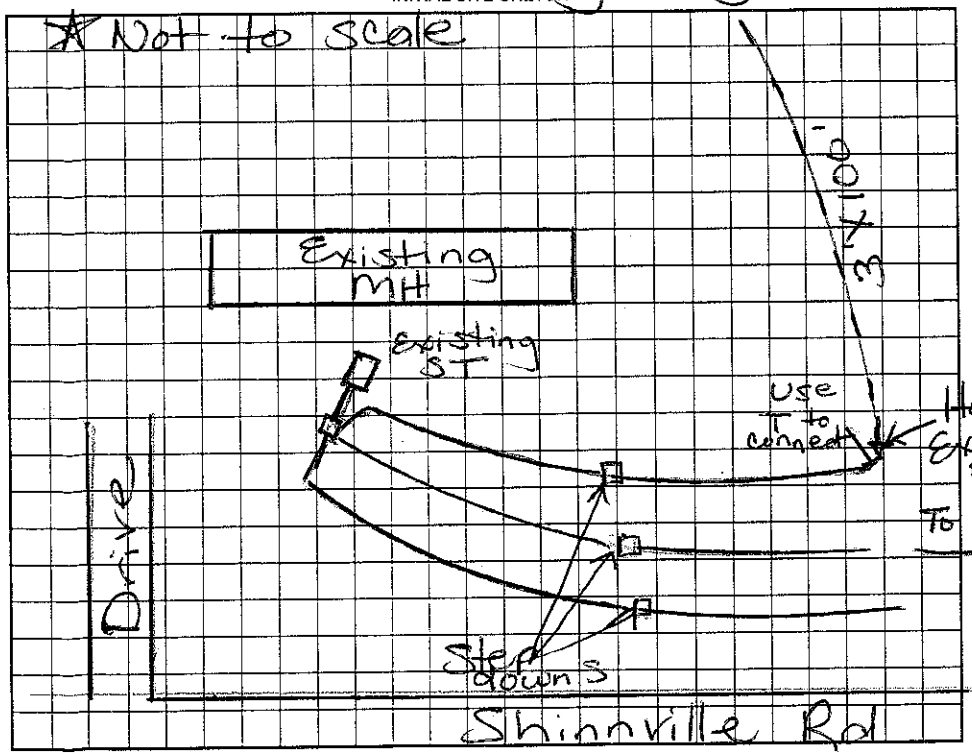

AS BUILT SKETCH

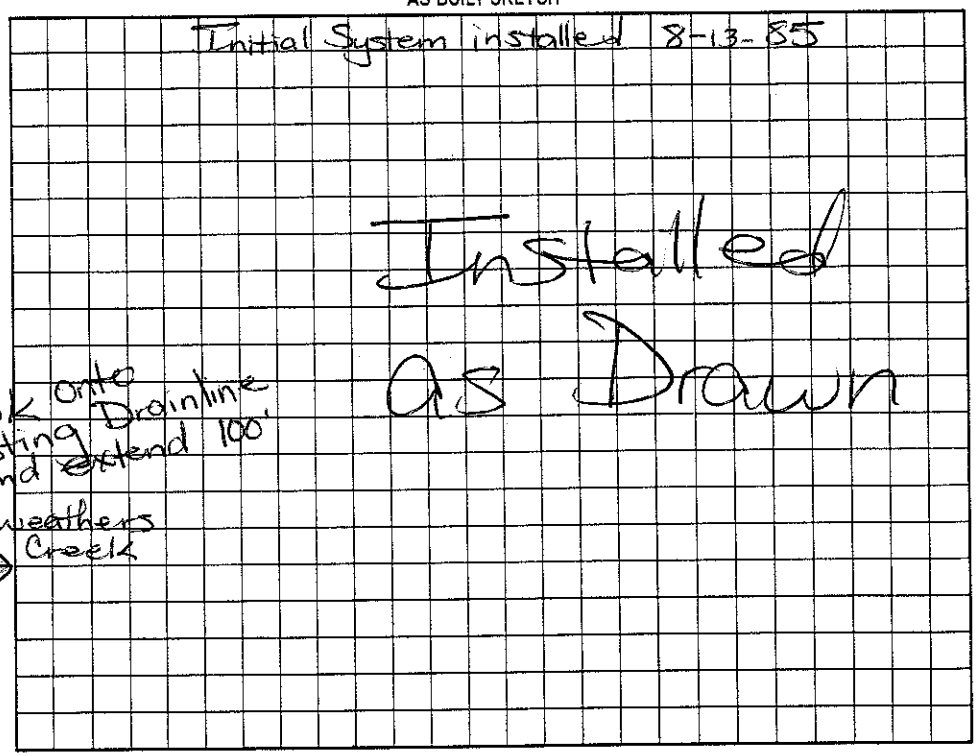

Permit can be suspended or revoked if any false information is supplied toward securing the permit/any unauthorized changes are made to the site/any unauthorized changes are made in the installation of the system. Improvement Permit with plat valid without expiration. Improvement Permit with site plan valid for sixty months. Authorization to Construct is valid for a period equal to that of Improvement Permit – not to exceed sixty months.

Signed:

Improvement Permit by: Maria H. Dotson RS date 9/26/2001

Authorization to Construct by: Maria H. Dotson RS date 9/26/2001

Installed by: A-1 Backhoe

Operation Permit by: Maria H. Dotson RS. date 10/3/2001

Existing System Inspection by: date

HEALTH DEPT. COPY: WHITE OWNER COPY (FINAL): YELLOW OWNER COPY (INITIAL): PINK