IREDELL COUNTY HEALTH DEPARTMENT

9770067333

STATESVILLE 704-878-5305 MOORESVILLE 704-664-5281

IMPROVEMENT PERMIT / CERTIFICATE OF COMPLETION / OPERATION PERMIT / EXISTING SYSTEM INSPECTION

PROPERTY DESCRIPTION NO. 1732 DATE 10/29/93 TAX MAP NO. 4IA7 Watershed: ☑ Yes ☐ No

OWNER OR CONTRACTOR RICHARD R. BEESMER II PHONE: Business _____ Home 528-3336

ADDRESS Rt 2 Box 305 CLEVELAND, NC. 27203

LOCATION SHINNVILLE RD. 2 MILES EAST OF I85 N ON (L)

SUBDIVISION N/A BLOCK / SECTION _____ LOT _____ LOT AREA 1.703 SITE CLASS. P DESIGN FLOW .360 L.T.A.R. .35

Septic Tank: 1000 Gallons; STB 358 Date 12/14/93
Pump Tank: _____ Gallons; PT _____ Date _____
Pump Make: _____ Model _____ Serial No. _____
Nitrification Field: No Fields 1 Square Feet 1028 Linear Feet 342
No Lines 4 Trench Width 3' Max Trench Bottom Depth 36" Gravel Depth 12"

☑ New System ☐ Repair System Type: I, (II), III, IV, V, VI
System Description: CONV - DIST. BOX
Repair System Description: CONV - DIST BOX
Maintenance Agreement Required: ☐ Yes ☑ No

☐ House/Mod. Home No. Bedrooms 3
☑ Mobile Home No. Bathrooms 2
☐ Business No. Employees _____
☐ Other _____
☐ Slab ☐ Crawl Space ☑ Basement w/plumbing ☐ Basement wo/plumbing


Water Supply:
☑ Individual
☐ Community
☐ Public

Comments: 4 - 85' x 3'
TRENCH DEPTH NO DEEPER THAN 36" TO TRENCH BOTTOM.

Comments:
Tank set on opposite side of drive
Contours travel to the left instead of the way shown

INITIAL SITE SKETCH

Scale 1" = 50'

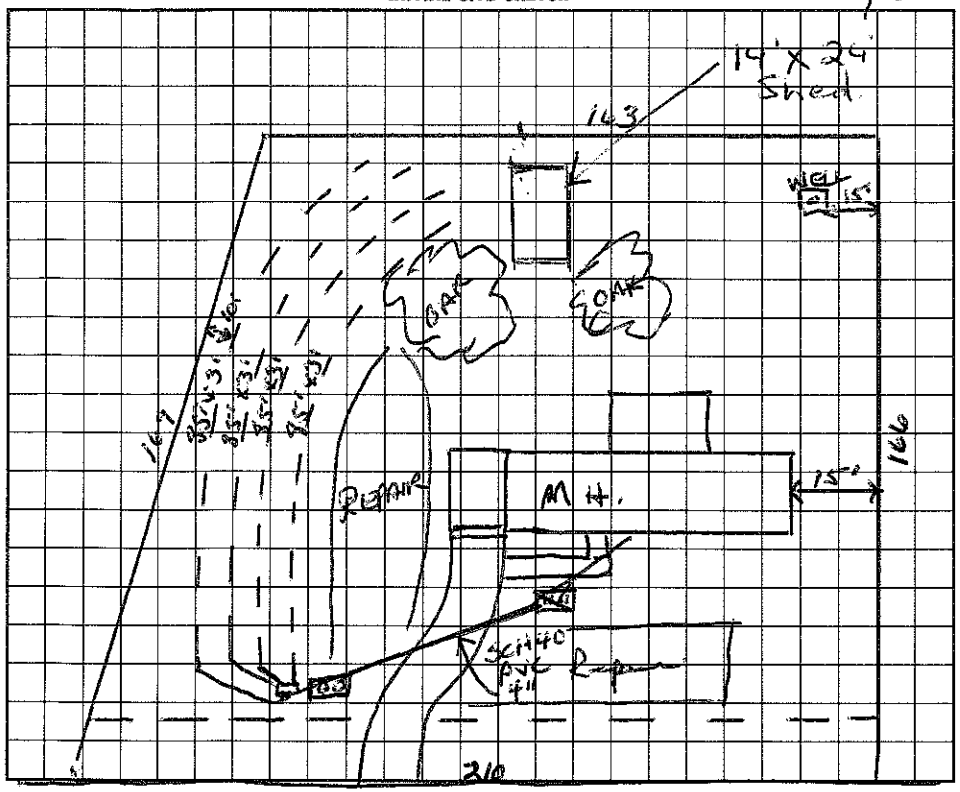

AS BUILT SKETCH

Installed 2/25/94

Location of the proposed 14'X24' Shed addition does not appear to impact the existing on-site septic system.**NOTE: Must keep any building at least 5ft from Septic

Marina Nolan REHS
Date: 7/5/13
ICHD-Environmental Health Division

I understand that this permit can be suspended or revoked if any false information is supplied toward securing the permit/any unauthorized changes are made to the site/any unauthorized changes are made in the installation of the system. Improvement Permit is valid for 60 months from date of issuance.

Signed: Richard R Beesmer II

Improvement Permit by: Wesley Sparks RS. date 10/29/93

Existing System Inspection by: _____ date _____

Installed by: A-1 Backhoe Denning Dalton

Certificate of Completion by: Wesley Sparks RS date 2/25/94

Operation Permit by: _____ date _____

HEALTH DEPT. COPY: WHITE INSPECTION COPY (FINAL): GREEN OWNER COPY (FINAL): YELLOW INSPECTION COPY (INITIAL): PINK OWNER COPY (INITIAL): GOLD