IREDELL COUNTY HEALTH DEPARTMENT

STATESVILLE 704-878-5305 MOORESVILLE 704-664-5281

IMPROVEMENT PERMIT / AUTHORIZATION TO CONSTRUCT / OPERATION PERMIT / EXISTING SYSTEM INSPECTION

PERMIT# 075953 PIN# 4760-97-9784 4770071705 DATE 9/18/98

OWNER OR CONTRACTOR William Tucker PHONE: Business Home 528-0535

ADDRESS 115 Prairie Ln Cleveland, NC 27013

LOCATION Shinnville Rd past Winthrow, TL Prairie Ln

SUBDIVISION BLOCK / SECTION LOT LOT AREA Acreage SITE CLASS. PS DESIGN FLOW 360gpd L.T.A.R.

Septic Tank: 1000 Gallons; Existing Date

Pump Tank: Gallons; PT Date

Pump Make: Model Serial No.

Nitrification Field: No Fields 1 Square Feet ~~350~~ 270 Linear Feet 1050

No Lines 4 at 90" Trench Width 36" Max Trench Bottom Depth 24-36" Gravel Depth 12"

☒ New System ☐ Repair System Type: I, II, III, IV, V, VI

System Description: Addition Gravity-Conventional Modified

Repair System Description:

Maintenance Agreement Required: ☐ Yes ☒ No

☐ House/Mod. Home ☒ Mobile Home ☐ Business ☐ Other

No. Bedrooms 3 No. Bathrooms 1½ No. Employees


☐ Slab ☒ Crawl Space ☐ Basement w/plumbing ☐ Basement wo/plumbing

Water Supply: ☒ Individual Shared ☐ Public ☐ Community

Comments:/Conditions: Existing System appears to be functioning Okay at time of inspection, No problems Noticed.

Comments:/Conditions: Upgrading home from 2-Bedroom to 3-Bedroom, Needs to add 1-80'x3' Drain line with D-Box.

Not to Scale **INITIAL SITE SKETCH**

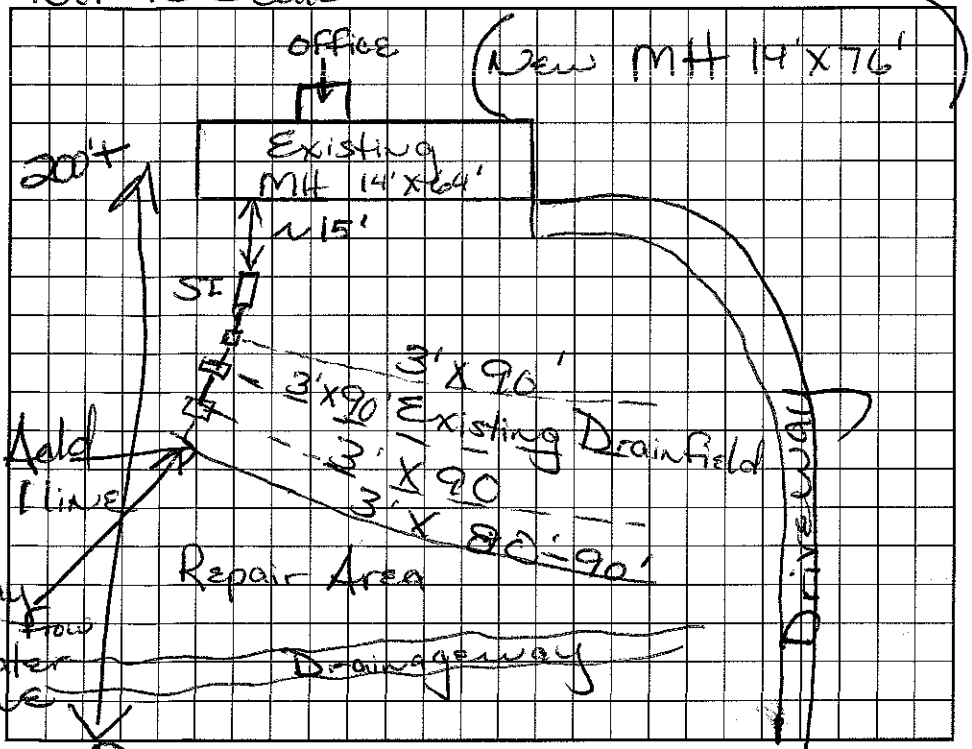

AS BUILT SKETCH

I understand that this permit can be suspended or revoked if any false information is supplied toward securing the permit/any unauthorized changes are made to the site/any unauthorized changes are made in the installation of the system. Improvement Permit with plat valid without expiration. Improvement Permit with site plan valid for sixty months. Authorization to Construct is valid for a period equal to that of Improvement Permit – not to exceed sixty months.

Signed: William E Tucker date

Improvement Permit by: Maria H. Dotson date 9/18/98

Authorization to Construct by: Maria H. Dotson date 9/18/98

Installed by: Curt Dunning

Operation Permit by: Wesley Parks RS. date 10/2/98

Existing System Inspection by: date

HEALTH DEPT. COPY: WHITE INSPECTION COPY (FINAL): GREEN OWNER COPY (FINAL): YELLOW INSPECTION COPY (INITIAL): PINK OWNER COPY (INITIAL): GOLD