IREDELL COUNTY HEALTH DEPARTMENT

STATESVILLE 704-878-5305 MOORESVILLE 704-664-5281

IMPROVEMENT PERMIT / AUTHORIZATION TO CONSTRUCT / OPERATION PERMIT / EXISTING SYSTEM INSPECTIO

PERMIT# 152693 PIN# 4770075303 DATE 9-12-08

OWNER OR APPLICANT Justin Davidson PHONE: Business 704-658-1723 ~~Home~~ Ashley Rollins

ADDRESS 1343 Shinnville Rd Cleveland NC 27013

LOCATION Shinnville, TR White Ridge, on L

SUBDIVISION — BLOCK / SECTION — LOT 3 LOT AREA .49 Ac SITE CLASS. PS DESIGN FLOW 360 L.T.A.R. .4

Septic Tank: Existing Gallons: STB ____ Date ____

Pump Tank: 9 Gallons: PT ____ Date ____

Pump Make: ____ Model ____ Serial No. ____

Nitrification Field: No Fields 1 Square Feet 300' Linear Feet 100'

No Lines 1@100' Trench Width 36" Max Trench Bottom Depth 36"

☐ New System ☐ Repair ☒ Expansion System Type: I (II) III IV V VI

System Description: Gravity Conventional

Repair System Description: Same

Maintenance Agreement Required: ☐ Yes ☒ No

☒ House/Mod. Home No. Bedrooms 3

☐ Mobile Home No. Persons 6

☐ Business No. Employees ____


☐ Other ____

Water Supply: ☒ Individual ☐ Public ☐ Community

Gravel Depth 12" ☒ Gravity ☐ Pressure ☐ Slab ☒ Crawl Space ☐ Basement w/plumbing ☐ Basement wo/plumbing

Comments/Conditions: Maintain set backs

Comments/Conditions:

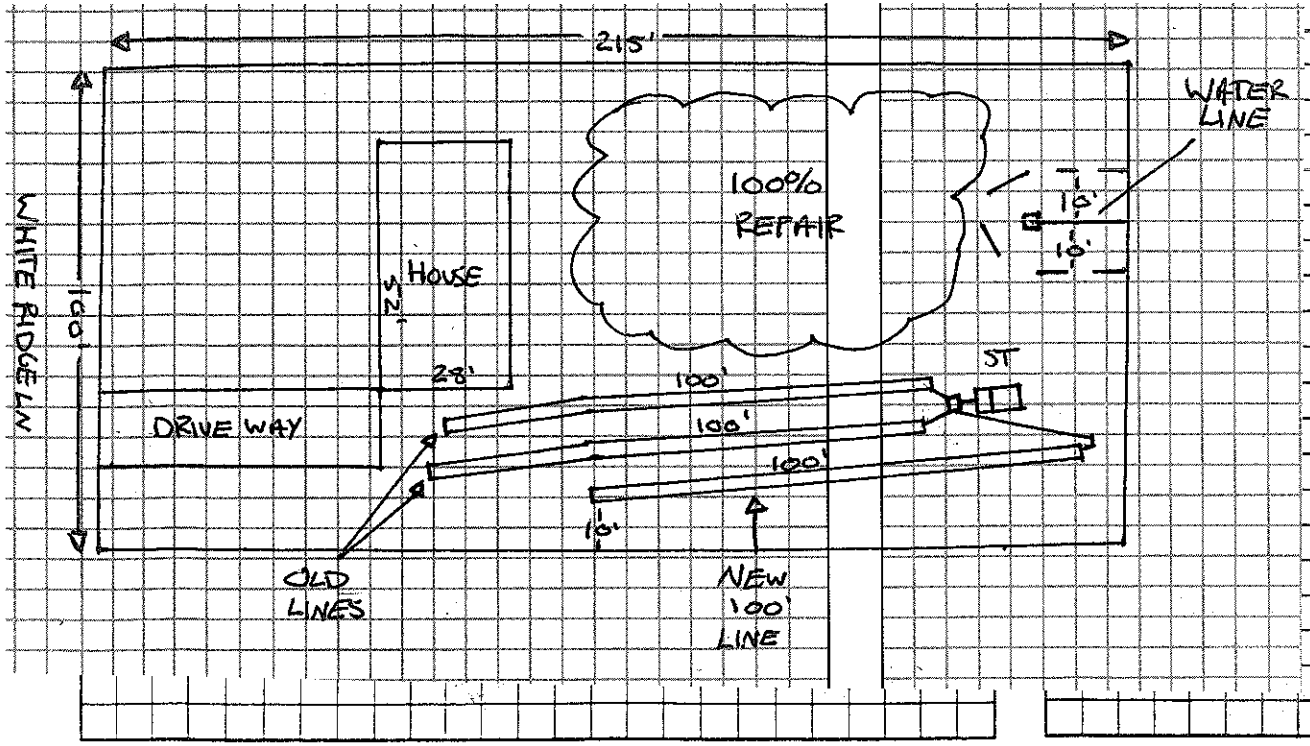

AS BUILT SKETCH

Permit can be suspended or revoked if any false information is supplied toward securing the permit/any unauthorized changes are made to the site/any unauthorized changes are made in the installation of the system. Improvement Permit with plat valid without expiration ☐ Improvement Permit with site plan valid for sixty months ☒ Authorization to Construct is valid for a period equal to that of Improvement Permit – not to exceed sixty months.

Signed: Justin Davidson date 9-17-08 Installed by: RIGGS GRADING

Improvement Permit by: [signature] date 9-15-08 Operation Permit by: [signature] date 11-12-08

Authorization to Construct by: [signature] date 11-7-08 Existing System Inspection by: ____ date ____

HEALTH DEPT. COPY: WHITE OWNER COPY (FINAL): YELLOW OWNER COPY (INITIAL): PINK