IREDELL COUNTY HEALTH DEPARTMENT

STATESVILLE 704-878-5305 150.00 Paid MOORESVILLE 704-664-5281

IMPROVEMENT PERMIT / AUTHORIZATION TO CONSTRUCT / OPERATION PERMIT / EXISTING SYSTEM INSPECTION

PERMIT# 104523 PIN# 4770 07 6303 DATE 2/12/02

OWNER OR CONTRACTOR Ray R. White Jr, PHONE: Business Home 704-528-3387

ADDRESS 1343 Shinnville Rd. Troutman, NC. 28166

LOCATION 115-21 N TR Shinnville Rd. TL White Ridge Ln. 1st drive on (L)

SUBDIVISION No BLOCK / SECTION LOT LOT AREA .69 SITE CLASS. PS DESIGN FLOW 360 L.T.A.R. .3

Septic Tank: EXISTING Gallons; STB Date

Pump Tank: Gallons; PT Date

Pump Make: Model Serial No.

Nitrification Field: No Fields 1 Square Feet 300 Linear Feet 100

No Lines 1 Trench Width 3' Max Trench Bottom Depth 36" Gravel Depth 12"

☐ New System ☐ Repair System Type: I (II) III. IV. V. VI

System Description: GRAV-CONVENTIONAL

Repair System Description:

Maintenance Agreement Required: ☐ Yes ☒ No

☒ House/Mod. Home No. Bedrooms 3

☐ Mobile Home No. Bathrooms 3

☐ Business No. Employees

☐ Other

☐ Slab ☒ Crawl Space ☐ Basement w/plumbing ☐ Basement wo/plumbing


Water Supply: ☒ Individual ☐ Public ☐ Community

Comments:/Conditions: * See Attached Easement Agreement *


Comments:/Conditions:

New D/B with Spud Low Line installed

INITIAL SITE SKETCH

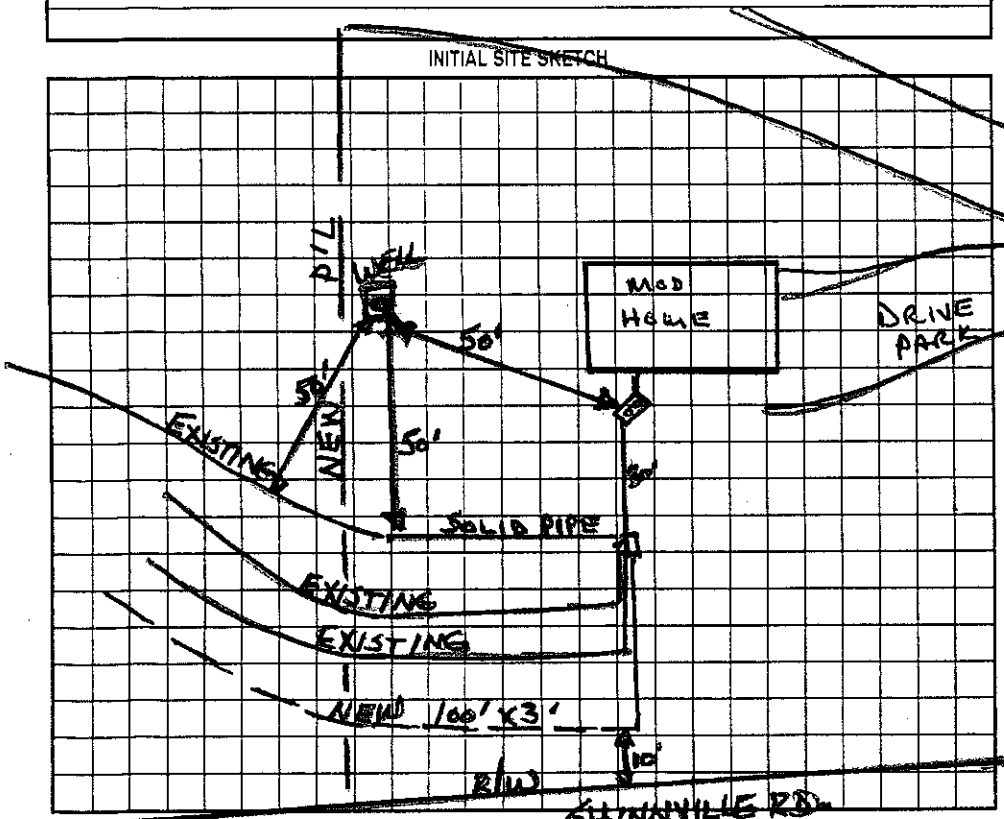

AS BUILT SKETCH

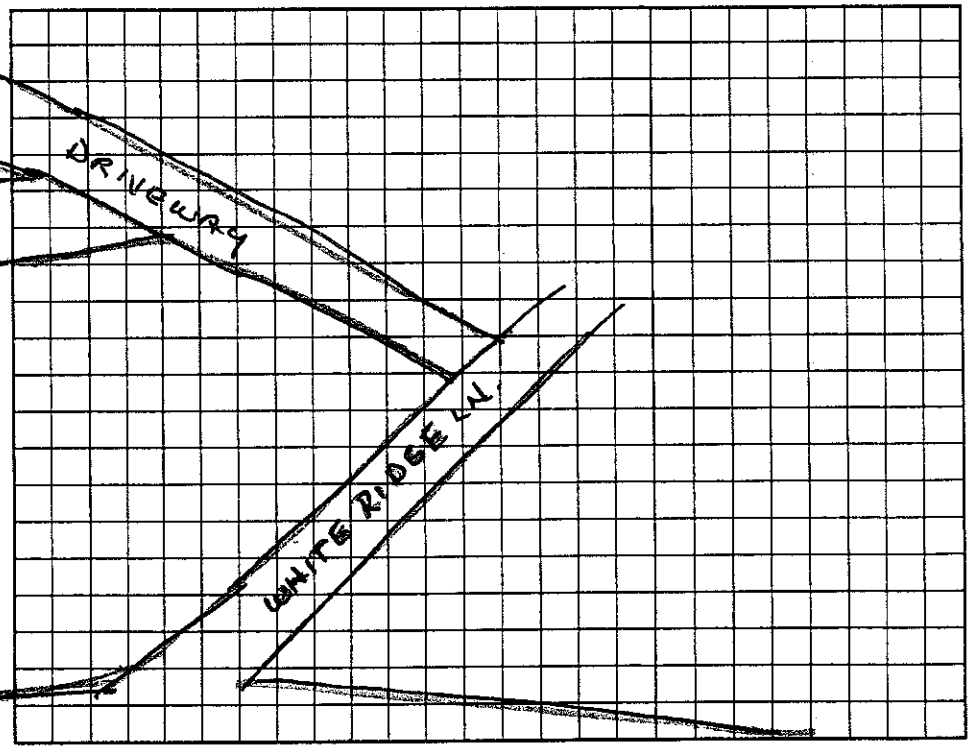

Permit can be suspended or revoked if any false information is supplied toward securing the permit/any unauthorized changes are made to the site/any unauthorized changes are made in the installation of the system. Improvement Permit with plat valid without expiration. Improvement Permit with site plan valid for sixty months. Authorization to Construct is valid for a period equal to that of Improvement Permit – not to exceed sixty months.

Signed: * [signature] date 2/14/02 Installed by: Craig Thompson.

Improvement Permit by: Wesley Sparks R.S. date 2/12/02 Operation Permit by: Wesley Sparks R.S. date 2/22/02

Authorization to Construct by: Wesley Sparks R.S. date 2/12/02 Existing System Inspection by: date

HEALTH DEPT. COPY: WHITE OWNER COPY (FINAL): YELLOW OWNER COPY (INITIAL): PINK