4770073535 75

IREDELL COUNTY HEALTH DEPARTMENT

STATESVILLE 704-878-5305 MOORESVILLE 704-664-5281

IMPROVEMENT PERMIT / CERTIFICATE OF COMPLETION / OPERATION PERMIT / EXISTING SYSTEM INSPECTION

PROPERTY DESCRIPTION NO. 20192 DATE 1/30/95 TAX MAP NO. 4J - A - 100 Watershed: ☐ Yes ☑ No

OWNER OR CONTRACTOR Raymond Richard White Jr. PHONE: Business _____ Home 528-3337

ADDRESS 1343 Shinnville Rd. Cleveland NC. 27013

LOCATION Shinnville Rd. on (L) at intersection of White Ridge Rd. on (L)

SUBDIVISION _____ BLOCK / SECTION _____ LOT _____ LOT AREA ~1.68M AC. SITE CLASS. P DESIGN FLOW 240 L.T.A.R. .3

Septic Tank: 1000 Gallons; STB 1612 Date 10/1/94

Pump Tank: _____ Gallons; PT _____ Date _____

Pump Make: _____ Model _____ Serial No. _____

Nitrification Field: No Fields 1 Square Feet 800 Linear Feet 300

No Lines 3 Trench Width 36" Max Trench Bottom Depth 36" Gravel Depth 12"

☑ New System ☐ Repair System Type: I, (II), III, IV, V, VI

System Description: CONV - DIST BOX

Repair System Description: SAME

Maintenance Agreement Required: ☐ Yes ☑ No

☐ House/Mod. Home ☑ Mobile Home ☐ Business ☐ Other

No. Bedrooms 2 No. Bathrooms 2 No. Employees ____


☐ Slab ☑ Crawl Space ☐ Basement w/plumbing ☐ Basement wo/plumbing

Water Supply: ☑ Individual ☐ Community ☐ Public FATHERS


Comments: 50' FROM WELL AS SHOWN
LINES ON CONTOUR IN DIRECTION SHOWN.

Comments:

INITIAL SITE SKETCH

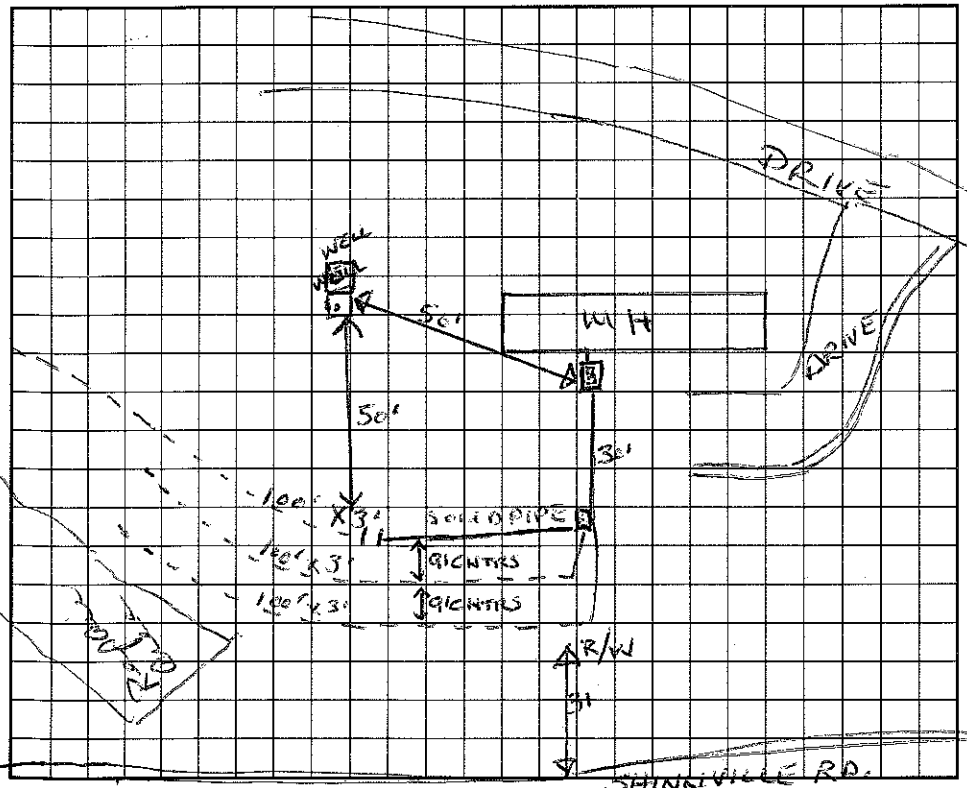

AS BUILT SKETCH

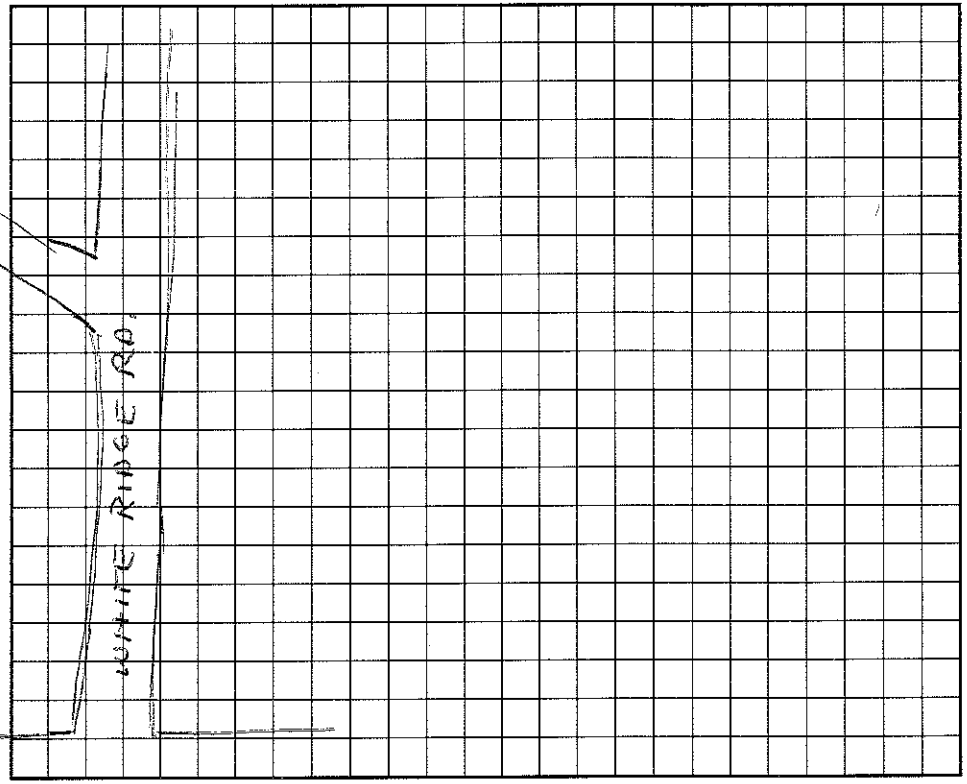

I understand that this permit can be suspended or revoked if any false information is supplied toward securing the permit/any unauthorized changes are made to the site/any unauthorized changes are made in the installation of the system. Improvement Permit is valid for 60 months from date of issuance.

Signed: Raymond R. White Jr.

Improvement Permit by: Wesley Sparks RS. date 1/30/95

Existing System Inspection by: _____ date _____

Installed by: Kenny Pearson

Certificate of Completion by: Wesley Sparks RS. date 2/3/95

Operation Permit by: _____ date _____

HEALTH DEPT. COPY: WHITE INSPECTION COPY (FINAL): GREEN OWNER COPY (FINAL): YELLOW INSPECTION COPY (INITIAL): PINK OWNER COPY (INITIAL): GOLD