IREDELL COUNTY HEALTH DEPARTMENT

STATESVILLE 704-878-5305 MOORESVILLE 704-664-5281

IMPROVEMENT PERMIT / AUTHORIZATION TO CONSTRUCT / OPERATION PERMIT / EXISTING SYSTEM INSPECTION

PERMIT# 080093 PIN# 4770081203 DATE 1/4/99

OWNER OR CONTRACTOR Richard Nelson PHONE: Business — Home —

ADDRESS 206 Apache Trail, Cleveland NC 27013

LOCATION 115' S, TL Shinnville Rd, TL Apache, on Rt

SUBDIVISION — BLOCK / SECTION — LOT ~~85~~ LOT AREA .85 SITE CLASS. PS DESIGN FLOW 360 L.T.A.R. —

Septic Tank: 1000 Gallons STB Date

Pump Tank: Gallons Existing Date

Pump Make: Model Serial No.

Nitrification Field: No Fields 1 Square Feet 900 Linear Feet 300

No Lines 3 @ 100 Trench Width — Max Trench Bottom Depth — Gravel Depth —

☐ New System ☐ Repair System Type: I, II, III, IV, V, VI

System Description:

Repair System Description Existing

Maintenance Agreement Required: ☐ Yes ☐ No

☒ House/Mod. Home No. Bedrooms 3

☐ Mobile Home No. Bathrooms

☐ Business No. Employees

☐ Other


☐ Slab ☐ Crawl Space ☐ Basement w/plumbing ☐ Basement wo/plumbing

Water Supply:
☒ Individual
☐ Public
☐ Community

Comments:/Conditions: Addition of 3 Bedroom is adequate for the size of System.

Comments:/Conditions:

INITIAL SITE SKETCH Not to Scale

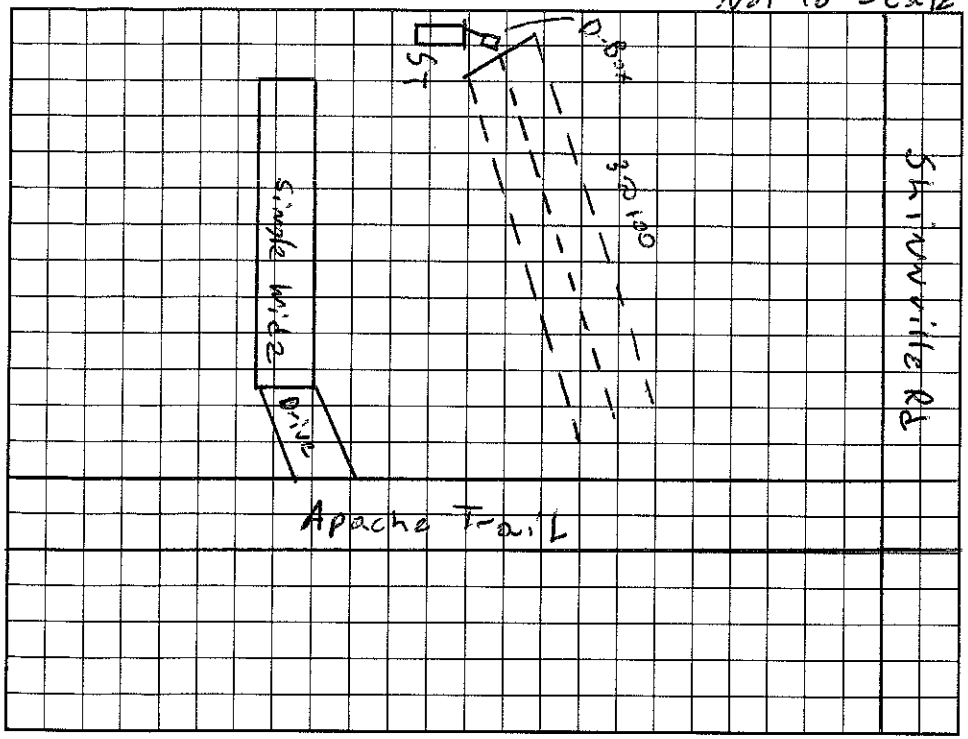

AS BUILT SKETCH

Permit can be suspended or revoked if any false information is supplied toward securing the permit/any unauthorized changes are made to the site/any unauthorized changes are made in the installation of the system. Improvement Permit with plat valid without expiration. Improvement Permit with site plan valid for sixty months. Authorization to Construct is valid for a period equal to that of Improvement Permit – not to exceed sixty months.

Signed: Jason Benton date 4/5/99 Installed by:

Improvement Permit by: date Operation Permit by: date

Authorization to Construct by: date Existing System Inspection by: Jeff Morgan date 1/4/99

HEALTH DEPT. COPY: WHITE OWNER COPY (FINAL): YELLOW OWNER COPY (INITIAL): PINK