IREDELL COUNTY HEALTH DEPARTMENT

Authorization to Construct — 600

TAYLORSVILLE 704-878-5305 MOORESVILLE 704-664-5281

IMPROVEMENT PERMIT / ~~CERTIFICATE OF COMPLETION~~ / OPERATION PERMIT / EXISTING SYSTEM INSPECTION

PROPERTY DESCRIPTION NO. 23791 DATE 6/6/96 TAX MAP NO. 4J A 42 4770-08-5606 Watershed: ☐ Yes ☒ No

OWNER OR CONTRACTOR Kimberly Foster PHONE: Business _____ Home 528-3031

ADDRESS 1412 Shinnville Rd. Cleveland, NC. 27013

LOCATION Shinnville Rd. 5.3 miles from 115-21N, TR X creek, MH on hill on (L) 1412 Shinnville Rd.

SUBDIVISION No BLOCK / SECTION _____ LOT _____ LOT AREA _____ SITE CLASS. _____ DESIGN FLOW _____ L.T.A.R. _____

Septic Tank: 1000 Gallons; STB 825 Date 6/7/96

Pump Tank: 900-1000 Gallons; PT 1087 Date 6/7/96

Pump Make: Liberty Model LE51A Serial No. 1318

Nitrification Field: No Fields ___ Square Feet EXISTING Linear Feet _____

No Lines _____ Trench Width _____ Max Trench Bottom Depth _____ Gravel Depth _____

☐ New System ☒ Repair System Type: I, II, (III), IV, V, VI

System Description: Pump to Existing System

Repair System Description: _____

Maintenance Agreement Required: ☐ Yes ☒ No

☒ House/Mod. Home No. Bedrooms 3

☐ Mobile Home No. Bathrooms 2

☐ Business No. Employees _____

☐ Other _____


☐ Slab ☒ Crawl Space ☐ Basement w/plumbing ☐ Basement wo/plumbing

Water Supply: ☒ Individual ☐ Community ☐ Public

Comments:

Comments: As shown on Auth to Const.

INITIAL SITE SKETCH

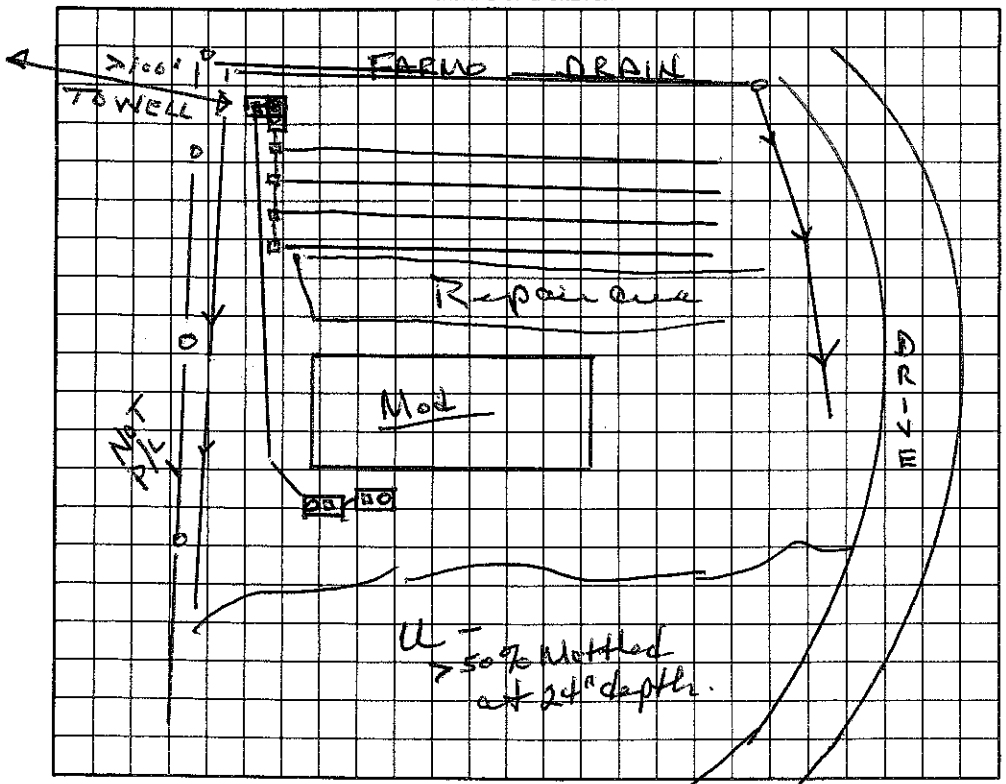

AS BUILT SKETCH

I understand that this permit can be suspended or revoked if any false information is supplied toward securing the permit/any unauthorized changes are made to the site/any unauthorized changes are made in the installation of the system.

Signed: Kimberly J Foster

Improvement Permit by: Wesley Sparks RS. date 6/6/96

Existing System Inspection by: Contract Wesley Sparks date 6/6/96

Installed by: Tim Ammons - John Foster.

Certificate of Completion by: _____ date _____

Operation Permit by: Wesley Sparks RS date 9/9/96

HEALTH DEPT. COPY: WHITE INSPECTION COPY (FINAL): GREEN OWNER COPY (FINAL): YELLOW INSPECTION COPY (INITIAL): PINK OWNER COPY (INITIAL): GOLD