IREDELL COUNTY HEALTH DEPARTMENT

Statesville Office (704) 878-5305 Mooresville Office (704) 660-3625 PERMIT # 206993

IMPROVEMENT PERMIT / AUTHORIZATION TO CONSTRUCT / OPERATION PERMIT / EXISTING SYSTEM

PIN # 4770103252

APPLICANT: Bryan K Chodfelter APPLICANT ADDRESS: 1824 Triplett Rd Mt Ulla NC 28125

SITE ADDRESS: 1808 Triplett Rd Mt Ulla NC 28125 PHONE: (704) 663 4041 ALT. PHONE: (704) 634 2500

SITE DIRECTIONS: Go Hwy 115 TR on Mazeppa Rd TL on Triplett Rd 1mi on left

SUBDIVISION: SECTION: LOT # LOT AREA: DESIGN FLOW: 360 L.T.A.R.:

Septic Tank existing 1000 (gal) STB Date
Pump Tank (gal) PT Date
Pump Make Model Serial #
Nitrification Fields 1 # Lines 3 Linear Ft: 315
Trench Width 36" Max. Trench Bottom Depth as needed Gravel Depth 24"


☐ New System ☐ Repair ☐ Expansion System Type: I II III IV V VI
System Description: 3-105 conventional drain lines
Repair System Description:
Maintenance Agreement Required: ☐ YES ☑ NO
☑ GRAVITY ☐ PRESSURE

☑ Residence No. Bedrooms 3
☐ Business No. Persons
☐ Other No. Employees
☐ Slab ☑ Crawl Space
☐ Basement w/plumbing ☐ Basement w/o plumbing

Water Supply: ☑ Private ☐ Public ☐ Community

Comments / Conditions: Authorization to construct a new 40x50 accessory bldg only. No plumbing fixtures or bathrooms applied for. All water lines must be 50' minimum from wells. No habitation occupancy in new bldg. No additional expansion of bedrooms or water flow above the existing 3BR or 360 gpd. New bldg must be minimum 5 ft from septic systems and 25' minimum from all wells.

INITIAL SITE/SKETCH

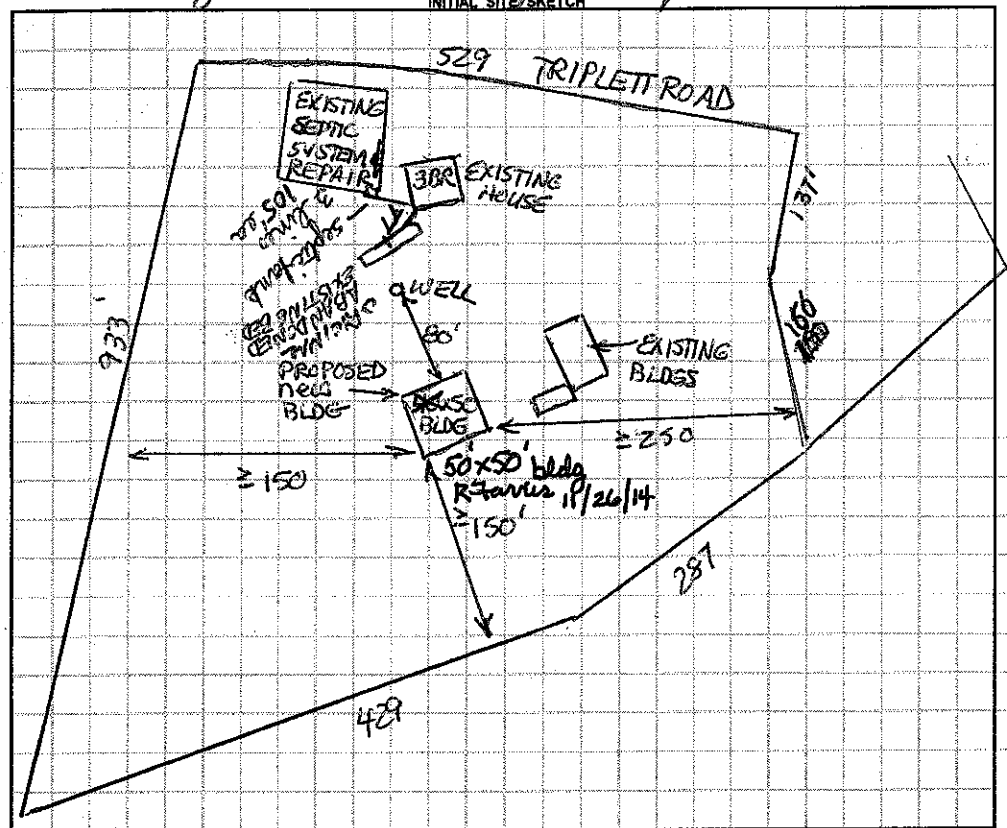

AS BUILT SKETCH

Permit can be suspended or revoked if any false information is supplied toward securing the permit / any unauthorized changes are made to the site / any unauthorized changes are made in the installation of the system. CONTACT A LOCATOR SERVICE PRIOR TO ANY EXCAVATION

☐ IMPROVEMENT PERMIT with site plan valid for 60 mos. ☐ AUTHORIZATION TO CONSTRUCT valid for period equal to IMPROVEMENT PERMIT--not to exceed 60 mo.

☐ Location of the proposed accessory bldg addition does not appear to impact the existing on-site septic system or well.**NOTE:

Owne te: Installed by:

IMPR Richard Farris REHS Date: 11/21/14 te: OPERATION PERMIT by: Date:

AUTH ICHD-Environmental Health Division te: Existing System Inspected by: Date:

Applicant (Final Approval) - YELLOW Applicant (Conditional Approval) - PINK