4770 11 7413

IREDELL COUNTY HEALTH DEPARTMENT

STATESVILLE 704-878-5305 MOORESVILLE 704-664-5281

IMPROVEMENT PERMIT / CERTIFICATE OF COMPLETION / OPERATION PERMIT / EXISTING SYSTEM INSPECTION

PROPERTY DESCRIPTION NO. 17131 DATE 10/5/93 TAX MAP NO. 4H-B-19A

OWNER OR CONTRACTOR GRIER B TOLBERT PHONE: Business _____ Home 663-4944

ADDRESS R+1 Box 174-A - MT ULLA, NC. 28125

LOCATION TRIPLETT RD., 2 MILES FROM 801 ON (L) BACK OFF ROAD.

SUBDIVISION N/A BLOCK / SECTION _____ LOT N/A LOT AREA ~1 AC SITE CLASS. P L.T.A.R. .25 - .3

Water Supply: ☑ Individual ☐ Community ☐ Public

Septic Tank: 1000 Gallons; STB 358 Date 9/26/93

Pump Tank: _____ Gallons; PT _____ Date _____

Nitrification Field: No Fields 1 Square Feet 630 Linear Feet 210

No Lines 3 Trench Width 3' Trench Depth 26-28" Gravel Depth 12"

☑ New System ☐ Repair System Type: I (II) II, IV, V, VI

System Description: CONV - GRAVITY

Repair System Description: CONV - GRAVITY

Maintenance Agreement Required: ☐ Yes ☑ No

☑ House/Mod. Home No. Bedrooms 2 Garbage Disposal: ☐ Yes ☑ No

☐ Mobile Home No. Bathrooms 2 Auto. Dishwasher: ☑ Yes ☐ No


☐ Business No. Employees _____ Auto. Washing Machine: ☑ Yes ☐ No

☐ Other _____ Other _____

☐ Slab ☑ Crawl Space ☐ Basement w/plumbing ☐ Basement wo/plumbing

Comments KEEP TRENCHES SHALLOW AND ON SLOPE CONTOUR IN DIRECTION

INITIAL SITE SKETCH

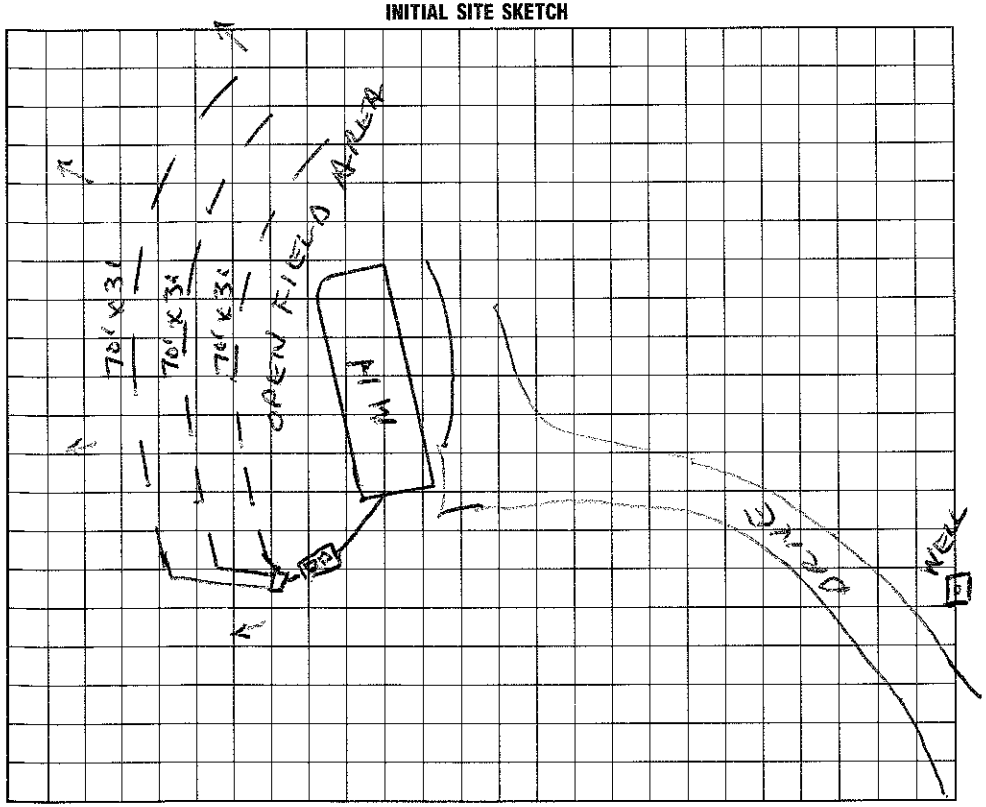

AS BUILT SKETCH

INSTALLED AS DRAWN
11/9/93

I understand that this permit can be suspended or revoked if any false information is supplied toward securing the permit/any unauthorized changes are made to the site/any unauthorized changes are made in the installation of the system. Improvement Permit is valid for 60 months from date of issuance.

Signed: Grier B. Tolbert

Improvement Permit by: Wesley Sparks RS. date 10/5/93

Existing System Inspection by: _____ date _____

Installed by: ~~KENNETH REITS~~ LARRY BLEVINS

Certificate of Completion by: Wesley Sparks RS. date 11/9/93

Operation Permit by: _____ date _____

HEALTH DEPT. COPY: WHITE INSPECTION COPY (FINAL): GREEN OWNER COPY (FINAL): YELLOW INSPECTION COPY (INITIAL): PINK OWNER COPY (INITIAL): GOLD