IREDELL COUNTY HEALTH DEPARTMENT

Statesville Office (704) 878-5305 Mooresville Office (704) 660-3625

PERMIT # 210264

IMPROVEMENT PERMIT / AUTHORIZATION TO CONSTRUCT / OPERATION PERMIT / EXISTING SYSTEM

PIN # 4770-15-0637

APPLICANT: NATE RANKHEAD APPLICANT ADDRESS: 1278 SHINNVILLE RD.

SITE ADDRESS: SAME PHONE: 704-941-1931 ALT. PHONE:

SITE DIRECTIONS:

SUBDIVISION: James + Linda Johnson III SECTION: LOT # -/- LOT AREA: 3 AC DESIGN FLOW: 360 L.T.A.R.: .3

Septic Tank 1000 (gal) STB Date
Pump Tank (gal) PT Date
Pump Make Model Serial #
Nitrification Fields 1 # Lines 3@100' Linear Ft: 300'
Trench Width 36" Max. Trench Bottom Depth 36" Gravel Depth —


☒ New System ☐ Repair ☐ Expansion System Type: I II ☒ III IV V VI
System Description: 25% REDUCTION
Repair System Description: SAME
Maintenance Agreement Required: ☐ YES ☒ NO
☒ GRAVITY ☐ PRESSURE

☒ Residence No. Bedrooms 3
☐ Business No. Persons
☐ Other No. Employees
☐ Slab ☒ Crawl Space
☐ Basement w/plumbing ☐ Basement w/o plumbing


Water Supply: ☒ Private ☐ Public ☐ Community

Comments / Conditions:

INITIAL SITE SKETCH

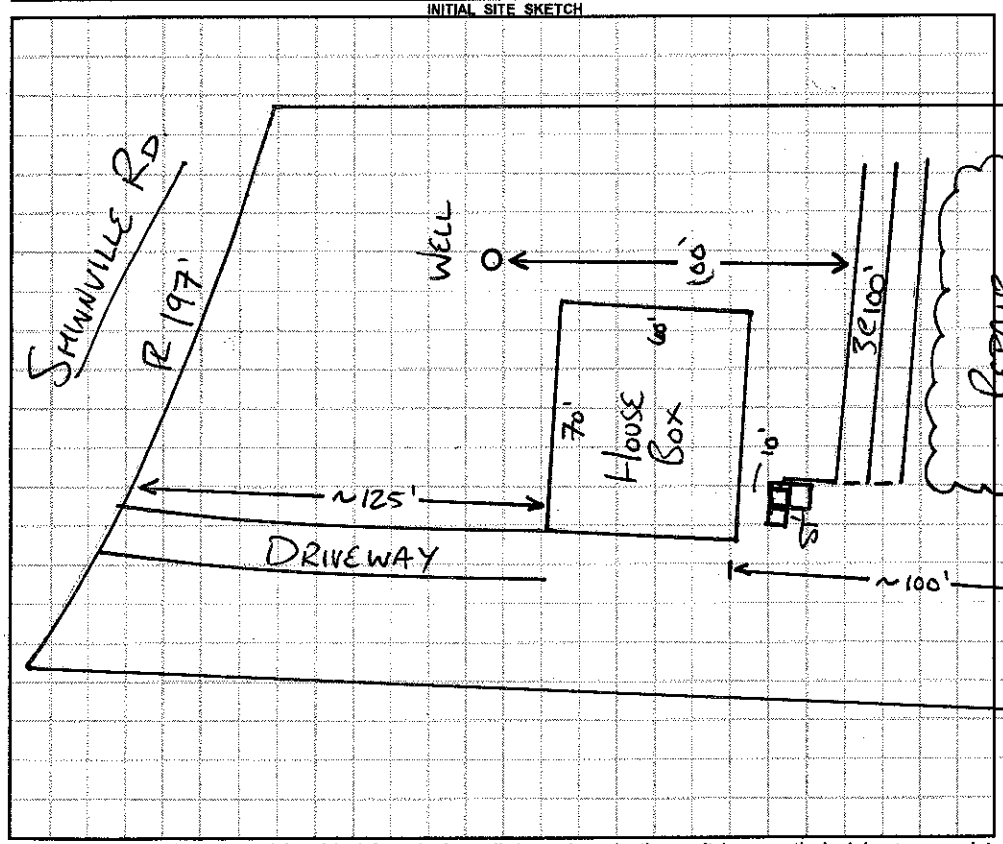

AS BUILT SKETCH

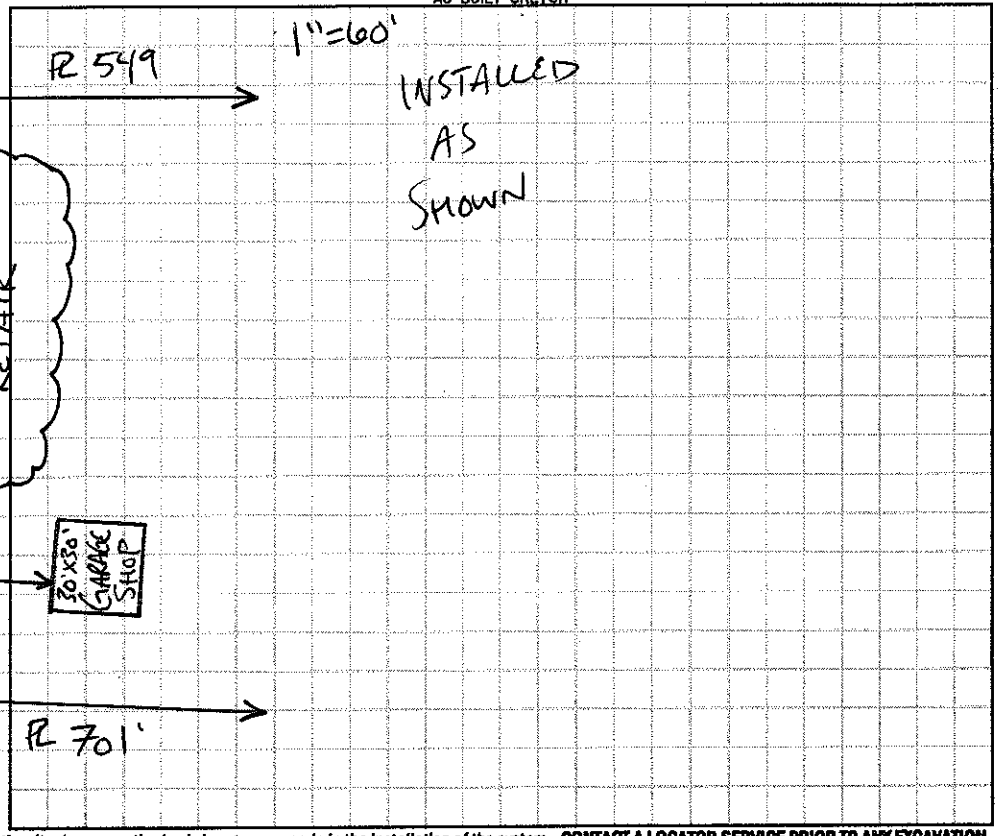

Permit can be suspended or revoked if any false information is supplied toward securing the permit / any unauthorized changes are made to the site / any unauthorized changes are made in the installation of the system. **CONTACT A LOCATOR SERVICE PRIOR TO ANY EXCAVATION**

☐ **IMPROVEMENT PERMIT** *with plat valid without expiration.* ☒ **IMPROVEMENT PERMIT** *with site plan valid for 60 mos.* ☒ **AUTHORIZATION TO CONSTRUCT** *valid for period equal to IMPROVEMENT PERMIT--not to exceed 60 mo.*

Owner / Applicant Signature: Date: 6/16/2015

IMPROVEMENT PERMIT by: APPROVED Date: JUN 16 2015

AUTHORIZATION TO CONSTRUCT by: APPROVED Date: JUN 19 2015

Installed by: BARNES

OPERATION PERMIT by: Date: 2016

Existing System Inspected by: Date:

Health Dept. Copy - WHITE Applicant (Final Approval) - YELLOW Applicant (Conditional Approval) - PINK