REDELL COUNTY HEALTH DEPARTMENT

STATESVILLE 704-878-5305 MOORESVILLE ~~704-664-5281~~

IMPROVEMENT PERMIT / AUTHORIZATION TO CONSTRUCT / OPERATION PERMIT / EXISTING SYSTEM INSPECTION

PERMIT # 156367 PIN # 4770-23-8313 DATE 5-18-09

OWNER or APPLICANT LARRY GIBSON PHONE: Business 704-663-0055 Home:

OWNER or APPLICANT ADDRESS 265 MCCRARY RD MOORESVILLE NC 28117

LOCATION / DIRECTIONS TRIPLETT RD, 1ST ON R AFTER CREEK

SUBDIVISION — BLOCK / SECTION — LOT # — LOT AREA 1AC DESIGN FLOW 360 L.T.A.R. .5

Septic Tank 1000 Gallons: STB 794 Date 8-19-09
Pump Tank — Gallons: P T — Date —
Pump Make — Model — Serial # —
Nitrification Field No Fields 1 No Lines 3 Linear Feet 180'
Trench Width 36" Max. Trench Bottom Depth 12" Gravel Depth —

☒ New System ☐ Repair ☐ Expansion System Type I II III IV V VI
System Description: SHALLOW GRAVITY 25% RED
Repair System Description: SAME
Maintenance Agreement Required ☐ YES ☒ NO
☒ GRAVITY ☐ PRESSURE


☒ Residence No. Bedrooms 3
☐ Business No. Persons —
☐ Other No. Employees —
☐ Slab ☒ Crawl Space
☐ Basement w/plumbing ☐ Basement w/o plumbing

Water Supply: ☒ Private ☐ Public ☐ Community


Comments / Conditions 1) MEET ALL REQUIRED SETBACKS 2) COVER SOIL SHALL BE ~~GRAV~~ OF GROUP I, II, III SOILS & A DEPTH OF AT LEAST 6"-12" 3) MUST BE INSTALLED ON CONTOUR TO KEEP 12" TRENCH BOTTOM

Comments / Conditions

INITIAL SITE SKETCH

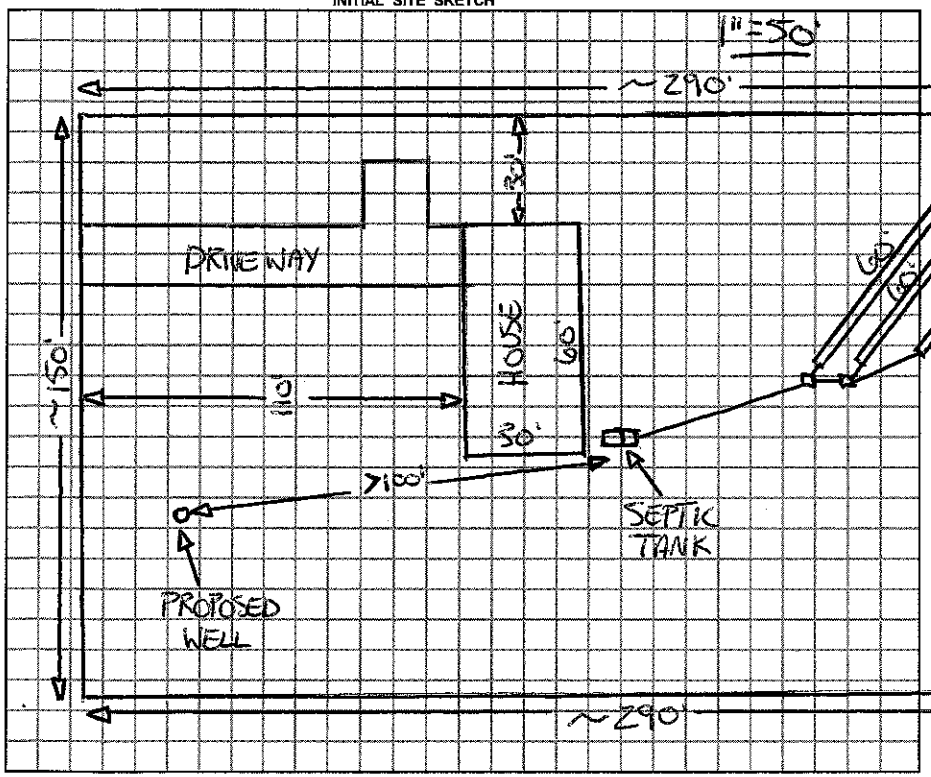

AS BUILT SKETCH

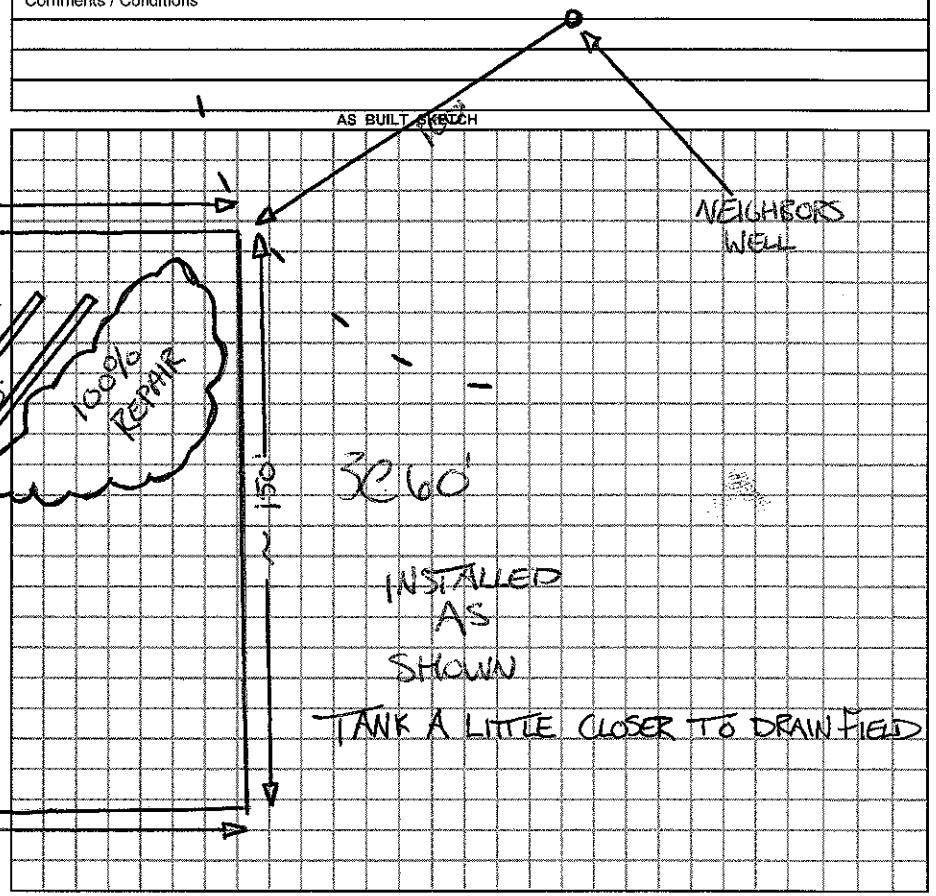

Permit can be suspended or revoked if any false information is supplied toward securing the permit / any unauthorized changes are made to the site / any unauthorized changes are made in the installation of the system.

☐ *IMPROVEMENT PERMIT w / plat valid without expiration.* ☒ *IMPROVEMENT PERMIT w / site plan valid for 60 mos.* ☒ *AUTHORIZATION TO CONSTRUCT valid for period equal to IMPROVEMENT PERMIT-not to exceed 60 mo.*

Owner / Applicant Signature: Larry Gibson Date —

Improvement Permit by: [signature] Date 6-29-09

Authorization to Construct by: [signature] Date 6-29-09

YOU SHOULD CONTACT A LOCATOR SERVICE PRIOR TO ANY EXCAVATION.

Installed by: —

Operation Permit by: [signature] ORBISON RS Date: 10-2009

Existing System Inspected by: — Date: —

WHITE COPY Environmental Health YELLOW COPY (Final) Owner / Applicant PINK COPY (Initial) Owner / Applicant