IREDELL COUNTY HEALTH DEPARTMENT

STATESVILLE 704-878-5305 MOORESVILLE 704-664-5281

IMPROVEMENT PERMIT / AUTHORIZATION TO CONSTRUCT / OPERATION PERMIT / EXISTING SYSTEM INSPECTION

PERMIT# 95657 PIN# 4770 250728 DATE 5/5/01

OWNER OR CONTRACTOR Coy Ray Wiles Jr PHONE: Business Home 528-3585

ADDRESS 1514 Tripplet Rd Cleveland NC 27013

LOCATION 801, L Tripplet, 4th drive on Lt after creek

SUBDIVISION BLOCK / SECTION LOT LOT AREA 5 Ac SITE CLASS. PS DESIGN FLOW 360 L.T.A.R. 0.3

Septic Tank: 1000 Gallons; STB 794 Date 11/12/01
Pump Tank: Gallons; PT Date
Pump Make: Model Serial No.
Nitrification Field: No Fields 1 Square Feet 1200 Linear Feet 400
No Lines 4@100' Trench Width 36" Max Trench Bottom Depth 36" Gravel Depth 12"

☒ New System ☐ Repair System Type: I (II) III, IV, V, VI
System Description: Gravity Conventional
Repair System Description: Pump Conventional
Maintenance Agreement Required: ☐ Yes ☒ No


☒ House/Mod. Home ☐ Mobile Home ☐ Business ☐ Other
No. Bedrooms 3 No. Bathrooms 2 No. Employees
☐ Slab ½ Crawl Space ☐ Basement w/plumbing ½ Basement wo/plumbing

Water Supply: ☒ Individual ☐ Public ☐ Community
Shared Well


Comments/Conditions: Install Lines on Contour - Keep Lines out of the low area - Keep any Wells 100' from septic system

Comments/Conditions:

INITIAL SITE SKETCH

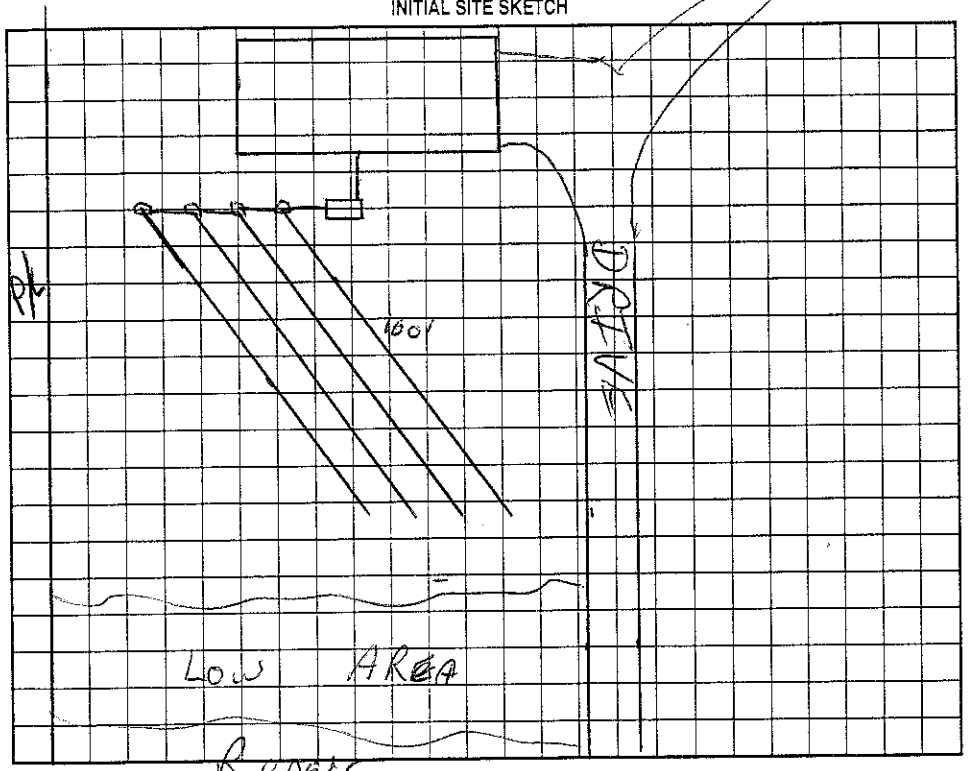

AS BUILT SKETCH

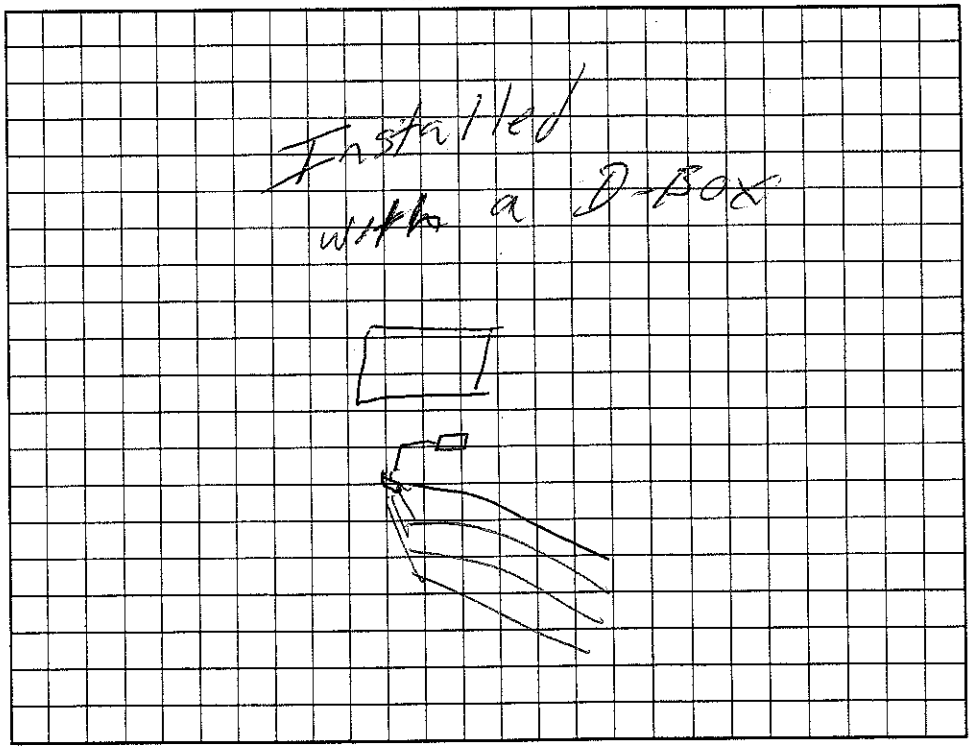

Permit can be suspended or revoked if any false information is supplied toward securing the permit/any unauthorized changes are made to the site/any unauthorized changes are made in the installation of the system. Improvement Permit with plat valid without expiration. Improvement Permit with site plan valid for sixty months. Authorization to Construct is valid for a period equal to that of Improvement Permit – not to exceed sixty months.

Signed: Coy R Wiles date 5-4-01

Improvement Permit by: RS date 5/5/01

Authorization to Construct by: RS date 5/5/01

Installed by: Orb. Son

Operation Permit by: RS date 2/14/02

Existing System Inspection by: date

HEALTH DEPT. COPY: WHITE OWNER COPY (FINAL): YELLOW OWNER COPY (INITIAL): PINK