(5.00) 4777025 7906

IREDELL COUNTY HEALTH DEPARTMENT

→ AUTHORIZATION TO CONSTRUCT

STATESVILLE 704-878-5305 MOORESVILLE 704-664-5281

IMPROVEMENT PERMIT / ~~CERTIFICATE OF COMPLETION~~ / OPERATION PERMIT / EXISTING SYSTEM INSPECTION

PROPERTY DESCRIPTION NO. 24976 DATE 9/18/96 TAX MAP NO. 4J-A-41(PT) Watershed: ☐ Yes ☑ No

OWNER OR CONTRACTOR GLENN BENNETT PHONE: Business ? Home 662-6224

ADDRESS 169 WIGGINS RD MOORESVILLE NC 28115

LOCATION OSWALT AMITY RD - TR TREPLETT RD 2 MILES ON RT.

SUBDIVISION ___ BLOCK / SECTION ___ LOT ___ LOT AREA ___ SITE CLASS. PS DESIGN FLOW 360 GPD L.T.A.R. .36 GPD/FT²

Septic Tank: 1000 Gallons; STB 794 Date 7/15/96

Pump Tank: ___ Gallons; PT ___ Date ___

Pump Make: ___ Model ___ Serial No. ___

Nitrification Field: No Fields 1 Square Feet 1200 Linear Feet 400

No Lines 5 Trench Width 36" Max Trench Bottom Depth 36" Gravel Depth 12"

☑ New System ☐ Repair System Type: I, II, III, IV, V, VI

System Description: GRAVITY CONVENTIONAL

Repair System Description: PANEL

Maintenance Agreement Required: ☐ Yes ☑ No

☐ House/Mod. Home No. Bedrooms 3

☑ Mobile Home No. Bathrooms 2

☐ Business No. Employees ___

☐ Other ___


☐ Slab ☑ Crawl Space ☐ Basement w/plumbing ☐ Basement wo/plumbing

Water Supply: ☑ Individual ☐ Community ☐ Public


Comments:

Comments: NEIGHBOR'S WELL

INITIAL SITE SKETCH 1"=40'

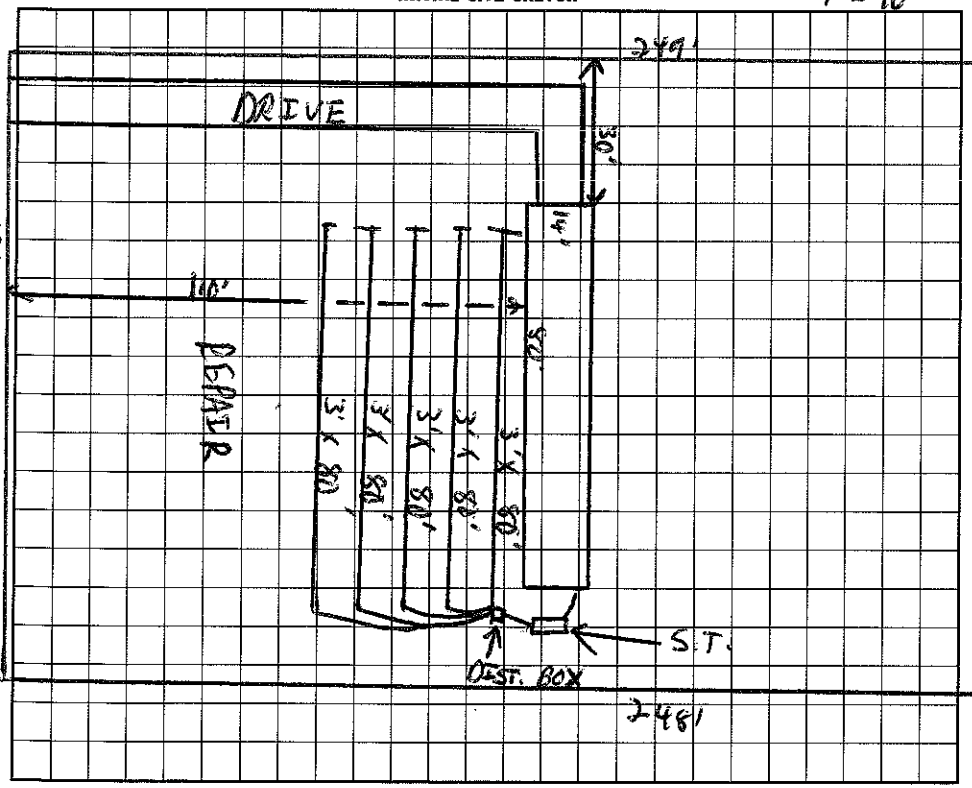

AS BUILT SKETCH

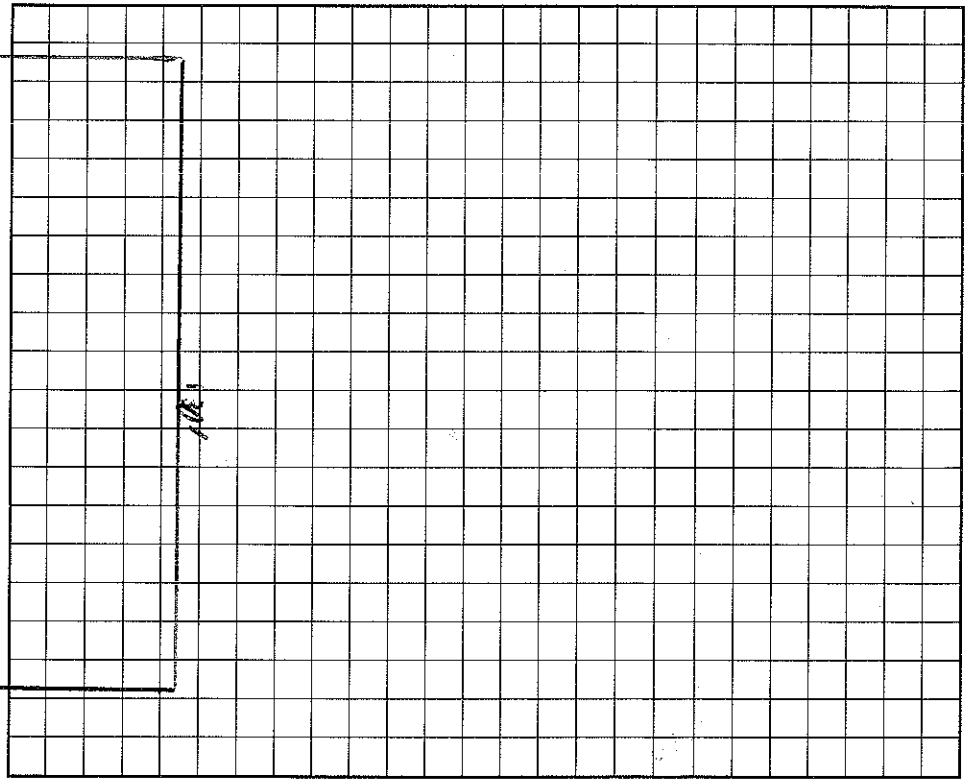

I understand that this permit can be suspended or revoked if any false information is supplied toward securing the permit/any unauthorized changes are made to the site/any unauthorized changes are made in the installation of the system.

Signed: Glenn E Bennett

Installed by: LARRY BEAM

Improvement Permit by: C. Bob Keen EHSI date 9/18/96

Certificate of Completion by: ___ date ___

AUTHORIZATION

~~Existing System Inspection by:~~ C. Bob Keen EHSI date 9/18/96

Operation Permit by: C. Bob Keen EHSI date 9-7-96

HEALTH DEPT. COPY: WHITE INSPECTION COPY (FINAL): GREEN OWNER COPY (FINAL): YELLOW INSPECTION COPY (INITIAL): PINK OWNER COPY (INITIAL): GOLD