IREDELL ... 'NTY HEALTH DEPARTMENT - *ENVIRONMENTAL HEALTH* ☐ STATESVILLE OFFICE 704-878-5305 ☑ MOORESVILLE OFFICE 704-664-5281

IMPROVE... T PERMIT / AUTHORIZATION TO CONSTRUCT / OPERATION PERMIT / EXISTING SYSTEM INSPECTION

PERMIT # IC1354 PIN # 4770-76-6145 DATE 6-8-12

OWNER WARREN SMITH APPLICANT: MIKE ATHANAS PHONE: Home/Cell # 704-576-3887 Business #

SITE ADDRESS CHARLES FARM RD OWNER / APPLICANT ADDRESS 1999 CANDLEWICK DR FORT MILL

SITE DIRECTIONS TRIPLETT TL CHARLES FARM, ON L

SUBDIVISION HIDDEN CREEK BLOCK / SECTION LOT # 5 LOT AREA .6 AC DESIGN FLOW 360 L.T.A.R. .3

Septic Tank 1000 Gallons: STB 760 Date 5-4-12

Pump Tank Gallons: P T Date

Pump Make Model Serial #

No. Nitrification Fields: 1 No. Lines 4 Linear Feet 300'

Trench Width 36" Max. Trench Bottom Depth 36"

☑ New System ☐ Repair ☐ Expansion System Type I II (III) IV V VI

System Description: GRAVITY 25%

Repair System Description: 25%

Maintenance Agreement Required ☐ YES ☑ NO

Gravel Depth — ☑ GRAVITY ☐ PRESSURE

☑ Residence No. Bedrooms 3

☐ Business No. Persons

☐ Other No. Employees

☐ Slab ☑ Crawl Space


☐ Basement w/plumbing ☐ Basement w/o plumbing

Water Supply: ☑ Private ☐ Public ☐ Community

Comments / Conditions ① STAY 5' FROM HOUSE & 10' FROM PROP LINES

② 100' WELL SET BACK

INITIAL SITE SKETCH

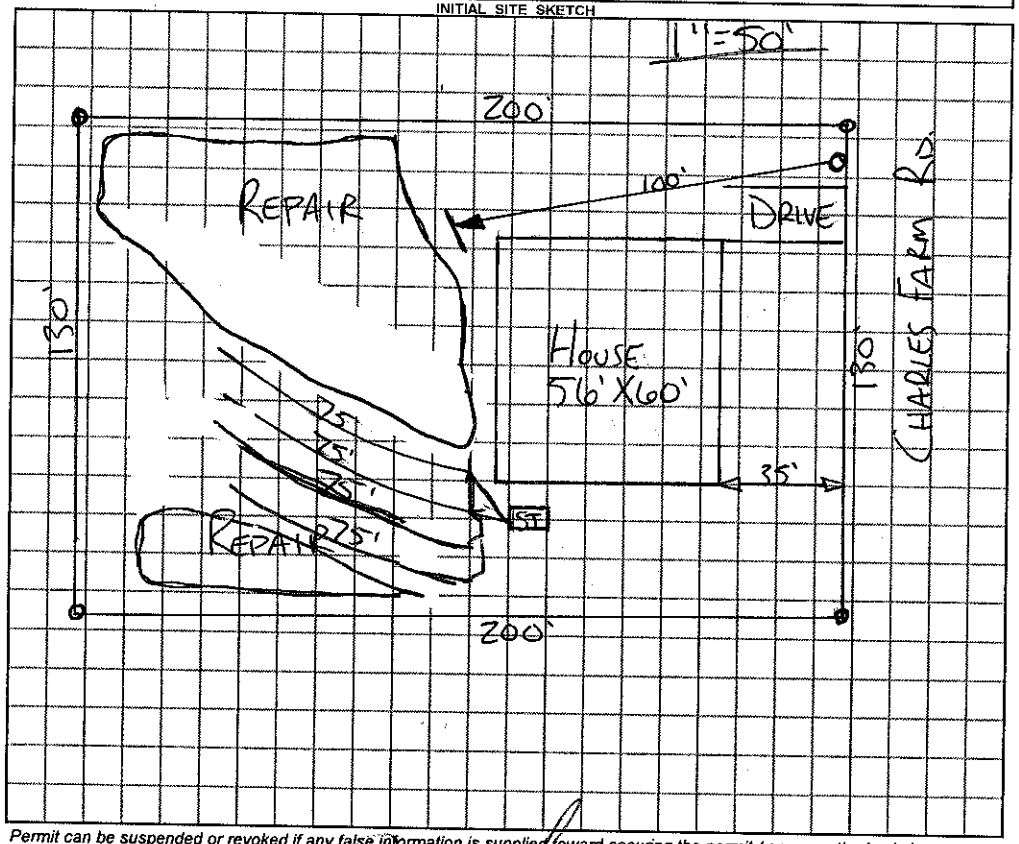

AS BUILT SKETCH

INSTALLED AS SHOWN

194W INSTALLED

Permit can be suspended or revoked if any false information is supplied toward securing the permit / any unauthorized changes are made to the site / any unauthorized changes are made in the installation of the system.

☐ *IMPROVEMENT PERMIT* with plat valid without expiration ☑ *IMPROVEMENT PERMIT* with plat valid without expiration. site plan valid 60 mo. ☑ *AUTHORIZATION TO CONSTRUCT* valid for period equal to IMPROVEMENT PERMIT--not to exceed 60 mo.

Owner / Applicant Signature: Date 6/12/12 Installed by: SPECIALTY SEPTIC

IMPROVEMENT PERMIT by: REHS Date 6-8-12 OPERATION PERMIT by: REHS Date 8-9-12

AUTHORIZATION TO CONSTRUCT by: REHS Date 6-12-12 Existing System Inspected by: REHS Date

YOU SHOULD CONTACT A LOCATOR SERVICE PRIOR TO ANY EXCAVATION

White Copy -- Environmental Health YELLOW COPY (Final) Owner / Applicant PINK COPY (Initial) Owner / Applicant