IREDELL COUNTY HEALTH DEPARTMENT

STATESVILLE 704-878-5305 MOORESVILLE 704-664-5281

IMPROVEMENT PERMIT / AUTHORIZATION TO CONSTRUCT / OPERATION PERMIT / EXISTING SYSTEM INSPECTION

PERMIT # 1213666 205748 PIN # 4770-26-6400 DATE 5-12-09

OWNER or APPLICANT R+S HOLDING GROUP LLC PHONE: Business 704-363-1622 Home:

OWNER or APPLICANT ADDRESS PO BOX 3190 MOORESVILLE NC 28117

LOCATION / DIRECTIONS TPIDI CT to Charles Farm Dr 3rd Lot on Right

SUBDIVISION HIDDEN CREEK BLOCK / SECTION -1- LOT # 52 LOT AREA .5AC DESIGN FLOW 480 L.T.A.R. .3

Septic Tank 1000 Gallons: STB 794 Date 4-13-15

Pump Tank 1000 Gallons: PT 27 Date 4-13-15

Pump Make ____ Model ____ Serial # ____

Nitrification Field No Fields 1 No Lines 5 Linear Feet 400'

Trench Width 36" Max. Trench Bottom Depth 36" Gravel Depth —

[X] New System [ ] Repair [ ] Expansion System Type I II III IV V VI

System Description: PM - 25% REDUCTION

Repair System Description: LP - PANEL BLOCK

Maintenance Agreement Required [ ] YES [X] NO INITIALLY

[ ] GRAVITY [X] PRESSURE

[X] Residence No. Bedrooms 4

[ ] Business No. Persons ____

[ ] Other No. Employees ____

[ ] Slab [X] Crawl Space

[ ] Basement w/plumbing [ ] Basement w/o plumbing

Water Supply: [X] Private [ ] Public [ ] Community

Comments / Conditions

Comments / Conditions 6/25/15 2 PT pressure set, Checked Electric alarm

INITIAL SITE SKETCH

SEE ATTACHED PLAN BY ROLLANS SOIL & ENVIRONMENTAL SERVICES

AS BUILT SKETCH

CHECKED TANKS & LINES & PM 5-20-15 JA

Permit can be suspended or revoked if any false information is supplied toward securing the permit / any unauthorized changes are made to the site / any unauthorized changes are made in the installation of the system.

[ ] *IMPROVEMENT PERMIT w / plat valid without expiration* [X] *IMPROVEMENT PERMIT w / site plan valid for 60 mos.* [ ] *AUTHORIZATION TO CONSTRUCT valid for period equal to IMPROVEMENT PERMIT-not to exceed 60 mo.*

Owner / Applicant Signature: [signature] Date 7-21-09

Improvement Permit by: [signature] Date 3-12-09

Authorization to Construct by: [signature] APPROVED SEP 08 2014 Date ____

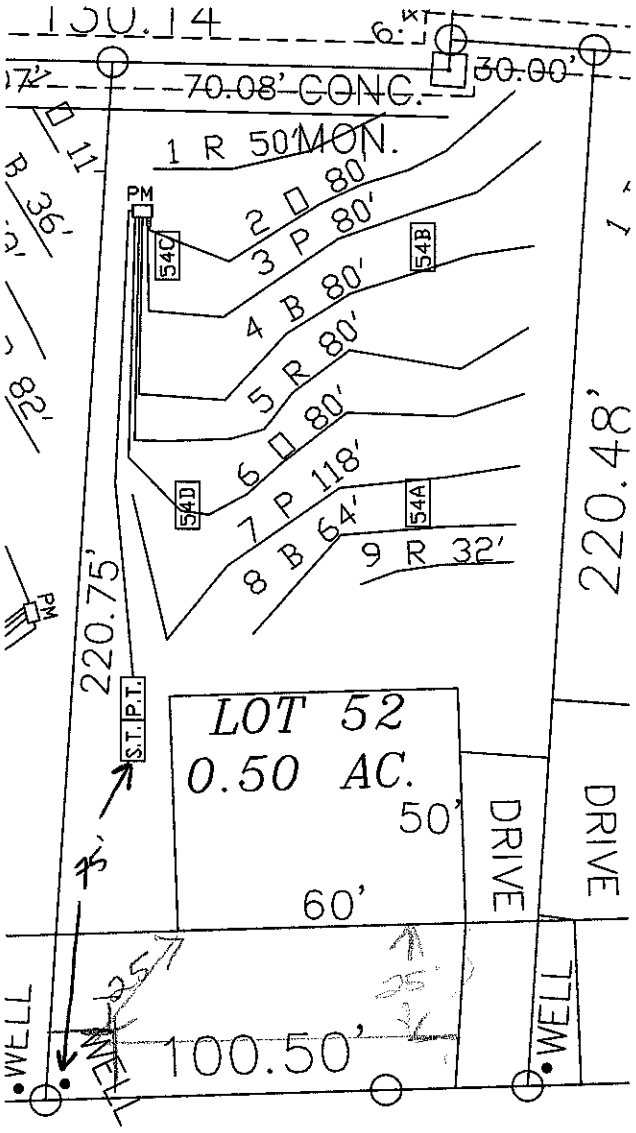
YOU SHOULD CONTACT A LOCATOR SERVICE PRIOR TO ANY EXCAVATION.

Installed by: SPECIALTY SEPTIC

Operation Permit by: [signature] RS Date: 6/25/15

Existing System Inspected by: ____ Date: ____

WHITE COPY Environmental Health YELLOW COPY (Final) Owner / Applicant PINK COPY (Initial) Owner / Applicant


150.14
6' KT
30.00'
70.08' CONC.
1 R 50 MON.
2 □ 80'
3 P 80'
4 B 80'
5 R 80'
6 □ 80'
7 P 118'
8 B 64'
9 R 32'
PM
54C
54B
54D
54A
11'
R 36'
82'
220.75'
220.48'
S.T.
P.T.
LOT 52
0.50 AC.
50'
60'
DRIVE
DRIVE
WELL
WELL
WELL
100.50'

1:40