IREDELL COUNTY HEALTH DEPARTMENT - *ENVIRONMENTAL HEALTH* ☐ STATESVILLE OFFICE 704-878-5305 ☒ MOORESVILLE OFFICE 704-664-5281

IMPROVEMENT PERMIT / AUTHORIZATION TO CONSTRUCT / OPERATION PERMIT / EXISTING SYSTEM INSPECTION

PERMIT # 121368 PIN # 4770-26-7400 DATE 6-8-12

OWNER WARREN SMITH APPLICANT: MIKE ATHANAS PHONE: Home/Cell # 704-576-3887 Business #

SITE ADDRESS CHARLES FARM RD OWNER / APPLICANT ADDRESS 1999 CANDLEWICK DR. FORT MILL

SITE DIRECTIONS TRIPLETT RD, CROSS CREEK, CHARLES FARM, ON R

SUBDIVISION HIDDEN CREEK BLOCK / SECTION LOT # 54 LOT AREA .49 AC DESIGN FLOW 360 L.T.A.R. .275

Septic Tank 1000 Gallons: STB 760 Date 5-4-12 ☒ New System ☐ Repair ☐ Expansion System Type I II (III) IV V VI

Pump Tank Gallons: P T Date System Description: GRAVITY 25%

Pump Make Model Serial # Repair System Description: PANEL

No. Nitrification Fields: 1 No. Lines 4 Linear Feet 328' Maintenance Agreement Required ☐ YES ☒ NO


Trench Width 36" Max. Trench Bottom Depth 36" Gravel Depth — ☒ GRAVITY ☐ PRESSURE

☒ Residence No. Bedrooms 3 ☐ Business No. Persons ☐ Other No. Employees ☐ Slab ☒ Crawl Space ☐ Basement w/plumbing ☐ Basement w/o plumbing

Water Supply ☑ Private ☐ Public ☐ Community

Comments / Conditions ① KEEP 5' FROM HOUSE & 10' FROM PROP LINES

INITIAL SITE SKETCH

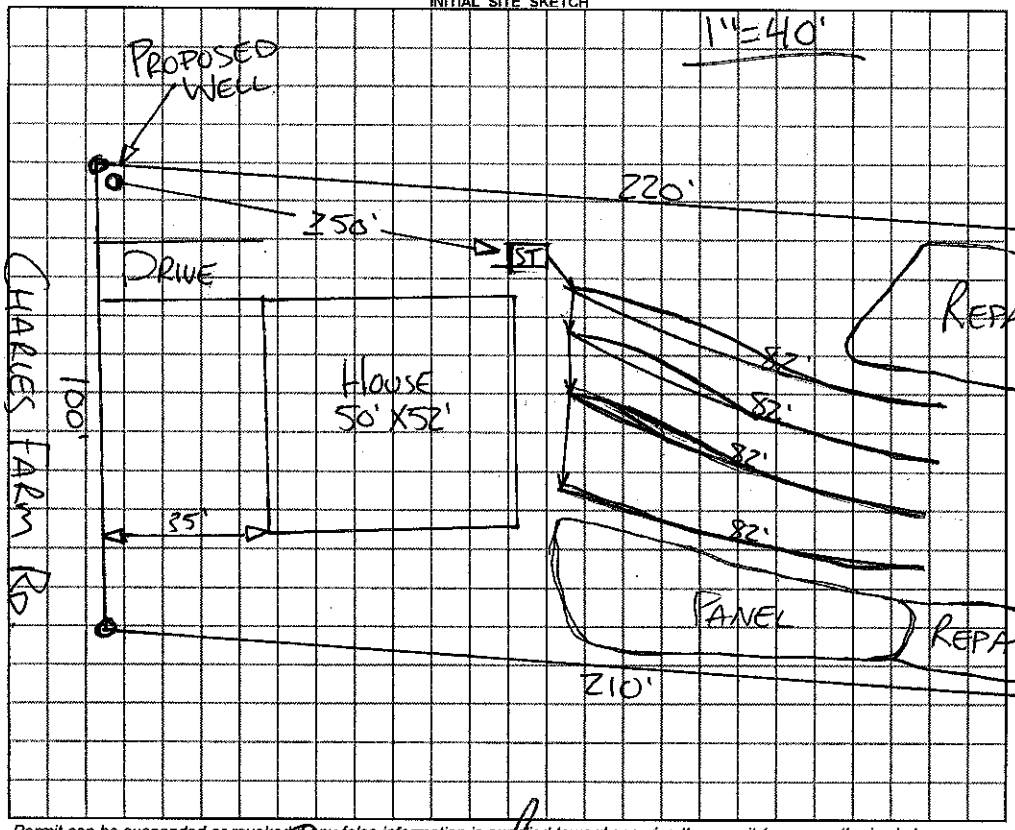

AS BUILT SKETCH

COULD NOT FIND TANK DATE

IQ4W INSTALLED

LINES START APPROX. 15 FROM HOUSE

INSTALLED AS SHOWN

Permit can be suspended or revoked if any false information is supplied toward securing the permit / any unauthorized changes are made to the site / any unauthorized changes are made in the installation of the system.

☐ ***IMPROVEMENT PERMIT*** with plat valid without expiration ☒ ***IMPROVEMENT PERMIT*** with plat valid without expiration. ☒ ***AUTHORIZATION TO CONSTRUCT*** valid for period equal to IMPROVEMENT PERMIT--not to exceed 60 mo.

Owner / Applicant Signature: Site plan valid for 60 days Date 6-12-12 Installed by: SPECIALTY SEPTIC

IMPROVEMENT PERMIT by: REHS Date 6-8-12 OPERATION PERMIT by: REHS Date 6-9-12

AUTHORIZATION TO CONSTRUCT by: REHS Date 6-12-12 Existing System Inspected by: REHS Date

YOU SHOULD CONTACT A LOCATOR SERVICE PRIOR TO ANY EXCAVATION

White Copy – Environmental Health YELLOW COPY (Final) Owner / Applicant PINK COPY (Initial) Owner / Applicant