4770274313

IREDELL COUNTY HEALTH DEPARTMENT

STATESVILLE 704-878-5305 MOORESVILLE 704-664-5281

IMPROVEMENT PERMIT / CERTIFICATE OF COMPLETION / OPERATION PERMIT / EXISTING SYSTEM INSPECTION

PROPERTY DESCRIPTION NO. 16638 DATE 7/26/93 TAX MAP NO. 4J A 25

OWNER OR CONTRACTOR HAROLD FREEZE PHONE: Business Home

ADDRESS R+2 BOX 323 CLEVELAND, NC.

LOCATION TRIPLETT RD, 80 N TL, X CREEK ~ .5 MILE ON (L) TWO STORY FRAME HOUSE

SUBDIVISION N/A BLOCK / SECTION LOT LOT AREA ~ 20 AC SITE CLASS. A L.T.A.R.

Water Supply: ☑ Individual ☐ Community ☐ Public

Septic Tank: 1500 Gallons; STB 780 Date 9/15/93

Pump Tank: Gallons; PT Date

Nitrification Field: No Field Square Feet 1716 Linear Feet 571

No Lines 4 5 Trench Width 36" Trench Depth 36" Gravel Depth 12"

☑ New System ☐ Repair System Type: I, ☑ II, IV, V, VI

System Description: CONV. - GRAVITY

Repair System Description: CONV - GRAVITY

Maintenance Agreement Required: ☐ Yes ☑ No

☑ House/Mod. Home No. Bedrooms ~~3~~ 4

☐ Mobile Home No. Bathrooms 3

☐ Business No. Employees

☐ Other

☐ Slab ☑ Crawl Space ☐ Basement w/plumbing ☐ Basement wo/plumbing

Garbage Disposal: ☐ Yes ☑ No


Auto. Dishwasher: ☑ Yes ☐ No

Auto. Washing Machine: ☑ Yes ☐ No

Other

Comments TRENCHES NO DEEPER THAN 36"

INITIAL SITE SKETCH

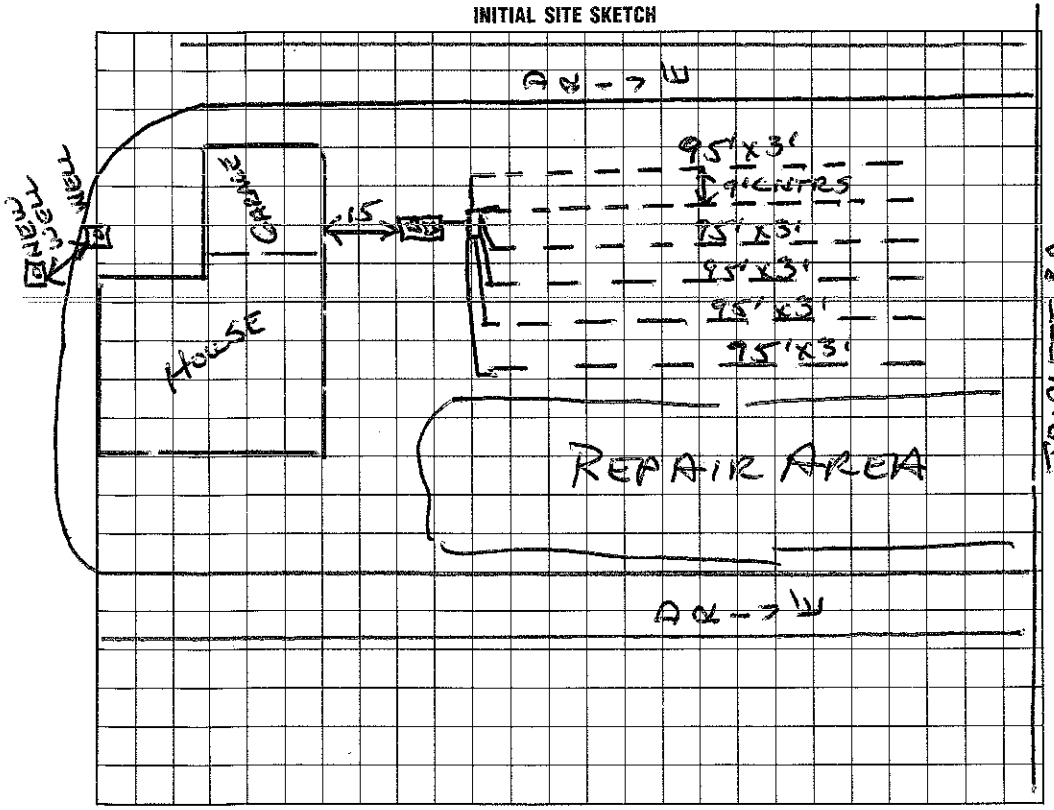

AS BUILT SKETCH

Installed as shown.
4/18/94

I understand that this permit can be suspended or revoked if any false information is supplied toward securing the permit/any unauthorized changes are made to the site/any unauthorized changes are made in the installation of the system. Improvement Permit is valid for 60 months from date of issuance.

Signed: Harold Freeze

Improvement Permit by: Wesley Sparks RS. date 7/26/93

Existing System Inspection by: date

Installed by: F.J Ervin

Certificate of Completion by: Wesley Sparks RS. date 4/18/94

Operation Permit by: date

HEALTH DEPT. COPY: WHITE INSPECTION COPY (FINAL): GREEN OWNER COPY (FINAL): YELLOW INSPECTION COPY (INITIAL): PINK OWNER COPY (INITIAL): GOLD