IREDELL COUNTY HEALTH DEPARTMENT

Authorization to Construct

4770347543

STATESVILLE 704-878-5305 MOORESVILLE 704-664-5281

IMPROVEMENT PERMIT / ~~CERTIFICATE OF COMPLETION~~ / OPERATION PERMIT / EXISTING SYSTEM INSPECTION

PROPERTY DESCRIPTION NO. 23159 DATE 7/18/97 TAX MAP NO. 4H A 45 Watershed: ☐ Yes ☒ No

OWNER OR CONTRACTOR Patricia + Jimmy Martinez PHONE: Business _____ Home 662-9725

ADDRESS 129 Scarlet Oaks Dr. Mooresville, NC. 28115

LOCATION 115-2 N TR Magnum Rd. TL Triplett Rd. X creek TR Forest View TR Settlers Haven on (R) at end of gravel

SUBDIVISION N/A BLOCK / SECTION _____ LOT _____ LOT AREA ~ 2.5 Ac SITE CLASS. PS DESIGN FLOW 480 L.T.A.R. .25

Septic Tank: 1000 Gallons; STB 794 Date 7/18/97

Pump Tank: _____ Gallons; PT _____ Date _____

Pump Make: _____ Model _____ Serial No. _____

Nitrification Field: No Fields 1 Square Feet 1920 Linear Feet 640

No Lines 4 Trench Width 36" Max Trench Bottom Depth 28" Gravel Depth 12"

☒ New System ☐ Repair System Type: I, (II), III, IV, V, VI

System Description: CONVENTIONAL - SHALLOW

Repair System Description: SAME

Maintenance Agreement Required: ☐ Yes ☒ No

☒ House/Mod. Home ☐ Mobile Home ☐ Business ☐ Other

No. Bedrooms 4 No. Bathrooms 3 No. Employees _____


☐ Slab ☒ Crawl Space ☐ Basement w/plumbing ☐ Basement wo/plumbing

Water Supply: ☒ Individual ☐ Community ☐ Public


Comments: Subsurface foundation required before completion may be issued.

Comments:

INITIAL SITE SKETCH

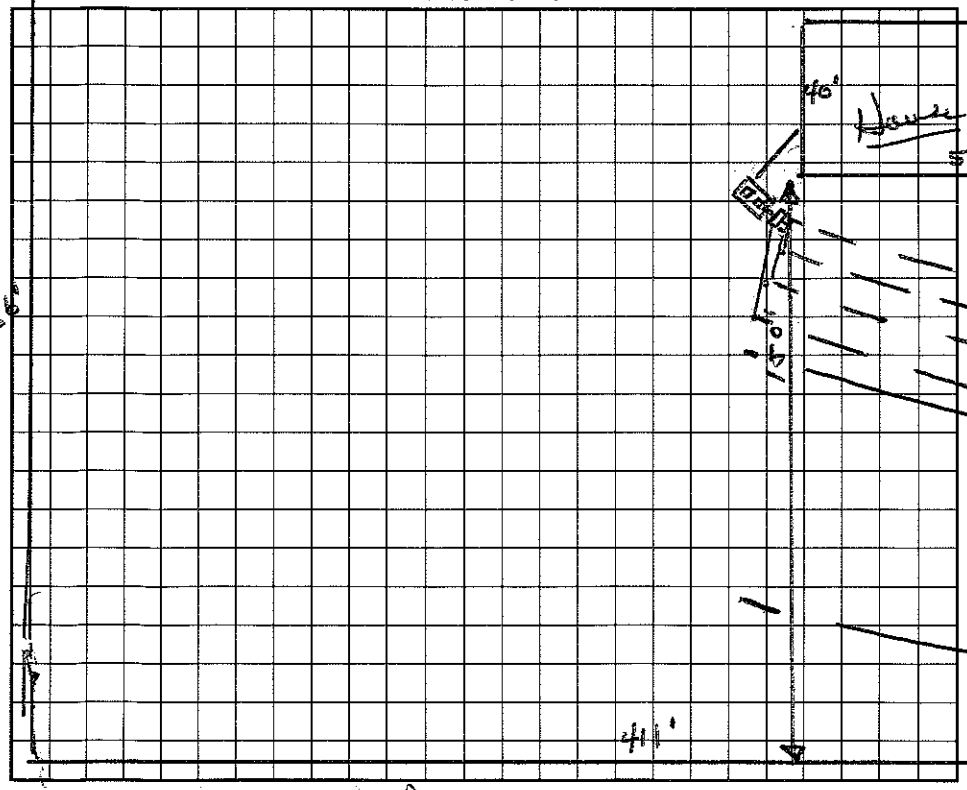

AS BUILT SKETCH 1" = 50'

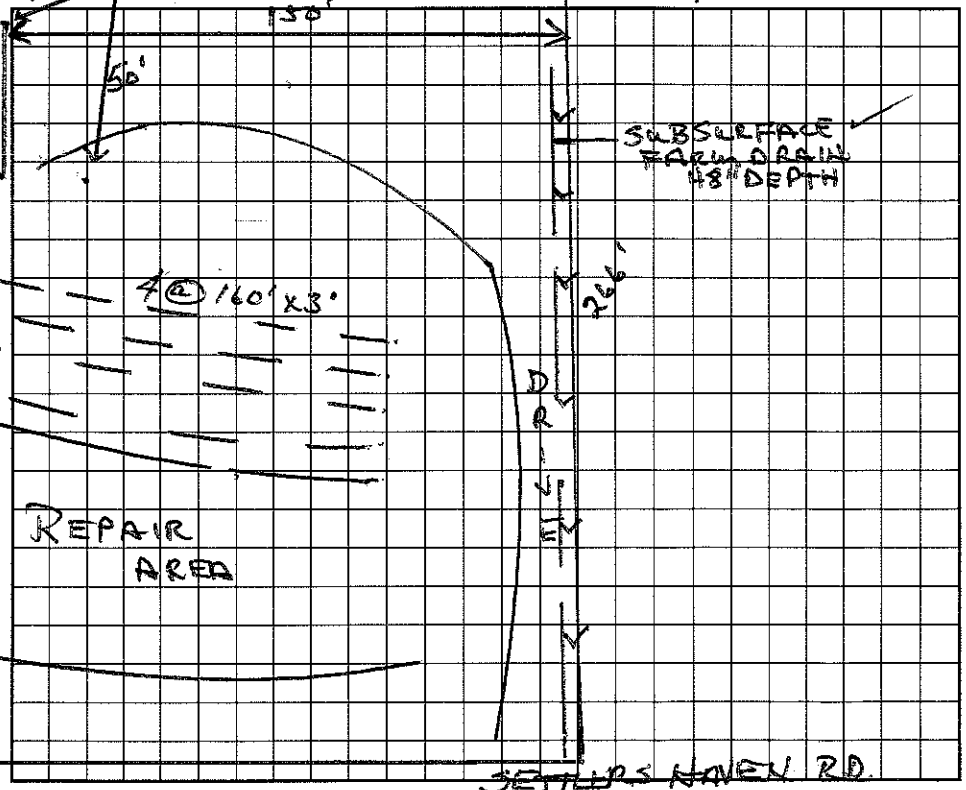

I understand that this permit can be suspended or revoked if any false information is supplied toward securing the permit/any unauthorized changes are made to the site/any unauthorized changes are made in the installation of the system. Improvement Permit is valid for 60 months from date of issuance.

Signed: Linda Summerville

Improvement Permit by: Wesley Sparks RS. date 7/18/97

Existing System Inspection by: Wesley Sparks RS. date 7/18/97

Installed by: Curt Dunning

Certificate of Completion by: Wesley Sparks RS. date 12/17/97

Operation Permit by: Wesley Sparks RS. date 12/17/97

Authorization to Construct

HEALTH DEPT. COPY: WHITE INSPECTION COPY (FINAL): GREEN OWNER COPY (FINAL): YELLOW INSPECTION COPY (INITIAL): PINK OWNER COPY (INITIAL): GOLD