4770352801

IREDELL COUNTY HEALTH DEPARTMENT

STATESVILLE 704-878-5305 MOORESVILLE 704-664-5281

IMPROVEMENT PERMIT / CERTIFICATE OF COMPLETION / OPERATION PERMIT / EXISTING SYSTEM INSPECTION

PROPERTY DESCRIPTION NO. 17755 DATE 2/4/93 TAX MAP NO. 4J A 23A Watershed: ☐ Yes ☐ No

OWNER OR CONTRACTOR Robert Wright PHONE: Business _____ Home 528-9922

ADDRESS Rt 2 Box 206 B Cleveland NC 27013

LOCATION Triplett Rd, x creek on R at top of grade in field

SUBDIVISION N/A BLOCK / SECTION _____ LOT _____ LOT AREA ~3 AC SITE CLASS. P DESIGN FLOW 360 L.T.A.R. .25

Septic Tank: 1000 Gallons; STB 358 Date 12/23/93

Pump Tank: _____ Gallons; PT _____ Date _____

Pump Make: _____ Model _____ Serial No. _____

Nitrification Field: No Fields 1 Square Feet 1440 Linear Feet 480

No Lines 4 Trench Width 3 Max Trench Bottom Depth 30-32" Gravel Depth 12"

☑ New System ☐ Repair System Type: I, II, III, IV, V, VI

System Description: DIST BOX - Conv.

Repair System Description: _____

Maintenance Agreement Required: ☐ Yes ☑ No

☑ House/Mod. Home No. Bedrooms 3

☐ Mobile Home No. Bathrooms 2

☐ Business No. Employees _____

☐ Other _____


☐ Slab ☐ Crawl Space ☐ Basement w/plumbing ☐ Basement wo/plumbing

Water Supply: ☑ Individual ☐ Community ☐ Public


Comments: Trenches no deeper than 32" to trench bottom;

Comments:

INITIAL SITE SKETCH

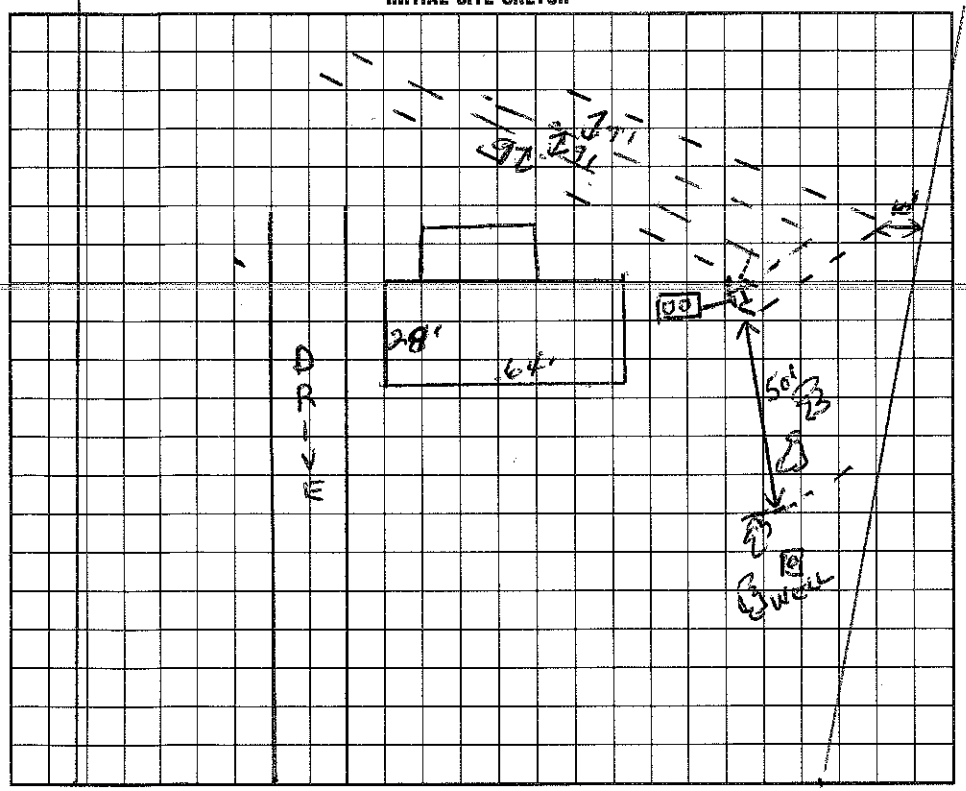

AS BUILT SKETCH

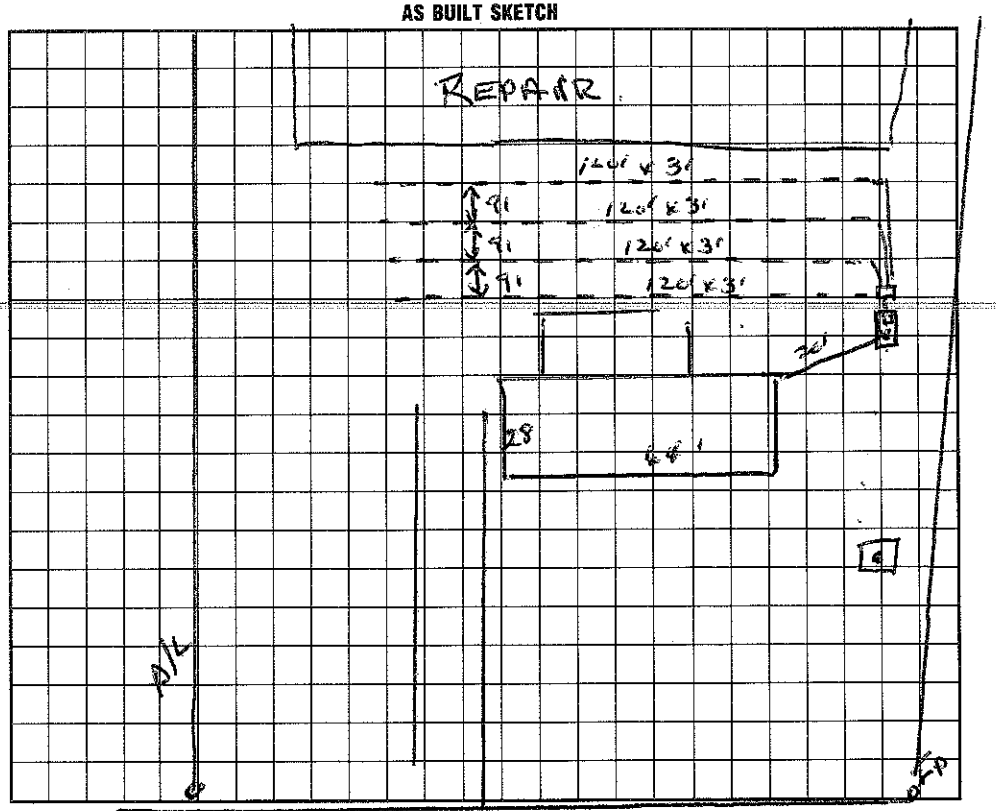

I understand that this permit can be suspended or revoked if any false information is supplied toward securing the permit/any unauthorized changes are made to the site/any unauthorized changes are made in the installation of the system. Improvement Permit is valid for 60 months from date of issuance.

Signed: X Robert Scott Wright

Improvement Permit by: Wesley Sparks RS. date 2/4/94

Existing System Inspection by: _____ date _____

TRIPLETT RD.

Installed by: A-1 BACKHOE DENNIS GALLIHER

Certificate of Completion by: Wesley Sparks RS. date 2/28/94

Operation Permit by: _____ date _____

HEALTH DEPT. COPY: WHITE INSPECTION COPY (FINAL): GREEN OWNER COPY (FINAL): YELLOW INSPECTION COPY (INITIAL): PINK OWNER COPY (INITIAL): GOLD