IREDELL COUNTY HEALTH DEPARTMENT

STATESVILLE 704-878-5305 MOORESVILLE 704-664-5281

IMPROVEMENT PERMIT / AUTHORIZATION TO CONSTRUCT / OPERATION PERMIT / EXISTING SYSTEM INSPECTION

PERMIT# 092949 PIN# 4770368872

OWNER OR CONTRACTOR Joseph Lee Myers DATE Nov. 18, 2000

ADDRESS 189 Settlers Haven Cleveland, N.C. 27013 PHONE: Business 528-3298 Home

LOCATION 80 I N TR Triplett Rd TR Forestview TL Settlers Haven on left NEAR END

SUBDIVISION BLOCK / SECTION LOT 15A LOT AREA 5Ac SITE CLASS. RS DESIGN FLOW 360gpd L.T.A.R. .03

Septic Tank: 1000 Gallons; STB 1007 Date 1-18-01

Pump Tank: Gallons; PT Date

Pump Make: Model Serial No.

Nitrification Field: No Fields 1 Square Feet 1200 Linear Feet 400

No Lines 4@100 Trench Width 36" Max Trench Bottom Depth 36" Gravel Depth 12"

☑ New System ☐ Repair System Type: I II III IV V VI

System Description: Gravity Conventional

Repair System Description: Gravity Conv / Innovative

Maintenance Agreement Required: ☐ Yes ☑ No

☑ House/Mod. Home No. Bedrooms 3

☐ Mobile Home No. Bathrooms 2.5

☐ Business No. Employees

☐ Other

☐ Slab ☑ Crawl Space ☐ Basement w/plumbing ☐ Basement wo/plumbing

Water Supply: ☑ Individual ☐ Public ☐ Community

EX well on Adjacent Lot


Comments:/Conditions:

Comments:/Conditions: Filter installed


Installed as Drawn

1"=100'

INITIAL SITE SKETCH

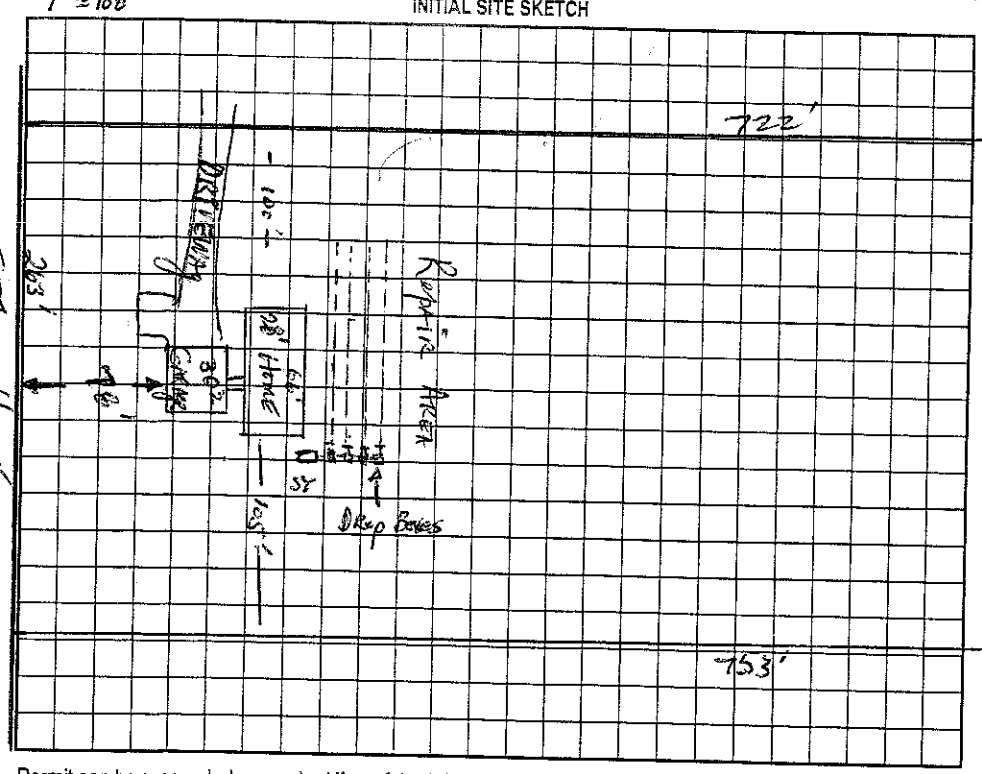

AS BUILT SKETCH

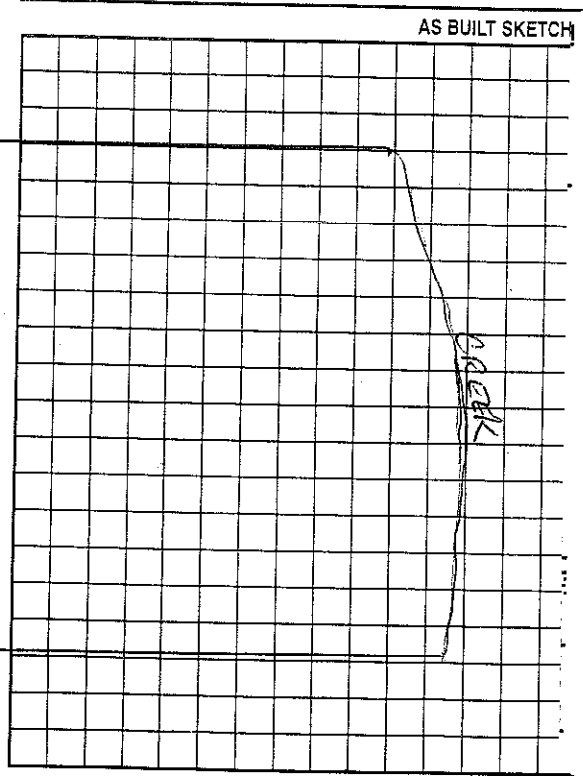

The proposed garage addition does not appear to impact the existing septic system.

**NOTE: See original permit showing garage

Anthony Cohen R.S.

Date: 4/14/09

ICHD-Environmental Health Division

Permit can be suspended or revoked if any false information is supplied toward securing the permit/any unauthorized changes are made to the site/any unauthorized changes are made in the installation of the system. Improvement Permit with plat valid without expiration. Improvement Permit with site plan valid for sixty months. Authorization to Construct is valid for a period equal to that of Improvement Permit – not to exceed sixty months.

Signed: J Lee Myers

Improvement Permit by: D Hinson, RS date 11-18-00

Authorization to Construct by: D Hinson, RS date 11-18-00

Installed by: Wayne Clontz RS date 4/3/01

Operation Permit by: Marie H Holden RS date

Existing System Inspection by: date

HEALTH DEPT. COPY: WHITE OWNER COPY (FINAL): YELLOW OWNER COPY (INITIAL): PINK