IREDELL COUNTY HEALTH DEPARTMENT

STATESVILLE 704-878-5305 MOORESVILLE 704-664-5281

IMPROVEMENT PERMIT / AUTHORIZATION TO CONSTRUCT / OPERATION PERMIT / EXISTING SYSTEM INSP[illegible]ION

PERMIT# 07821 PIN# 4770372790PT DATE 5/26/99

OWNER OR CONTRACTOR Harold Freeze PHONE: Business _____ Home 704-528-6623

ADDRESS 1448 Triplet Rd, Cleveland NC 27013

LOCATION Oswalt Amity, TR Triplet, 1mile on left Rail Road Ranch Lane

SUBDIVISION _____ BLOCK / SECTION _____ LOT _____ LOT AREA 1.67 SITE CLASS. PS DESIGN FLOW 360 L.T.A.R. 1.3

Septic Tank: 1000 Gallons; STB 825 Date 5/23/61
Pump Tank: _____ Gallons; PT _____ Date _____
Pump Make: _____ Model _____ Serial No. _____
Nitrification Field: No Fields 1 Square Feet 1206 Linear Feet 402
No Lines 3 @ 134' Trench Width 36" Max Trench Bottom Depth 36" Gravel Depth 12"

☒ New System ☐ Repair System Type: I, (II), III, IV, V, VI
System Description: Conv./Grav.
Repair System Description: Chamber/Panel
Maintenance Agreement Required: ☐ Yes ☐ No


☒ House/Mod. Home No. Bedrooms 3
☐ Mobile Home No. Bathrooms 2
☐ Business No. Employees ____
☐ Other _____
☐ Slab ☑ Crawl Space ☐ Basement w/plumbing ☐ Basement wo/plumbing

Water Supply:
☑ Individual
☐ Public
☐ Community

Comments:/Conditions:

Comments:/Conditions:

INITIAL SITE SKETCH

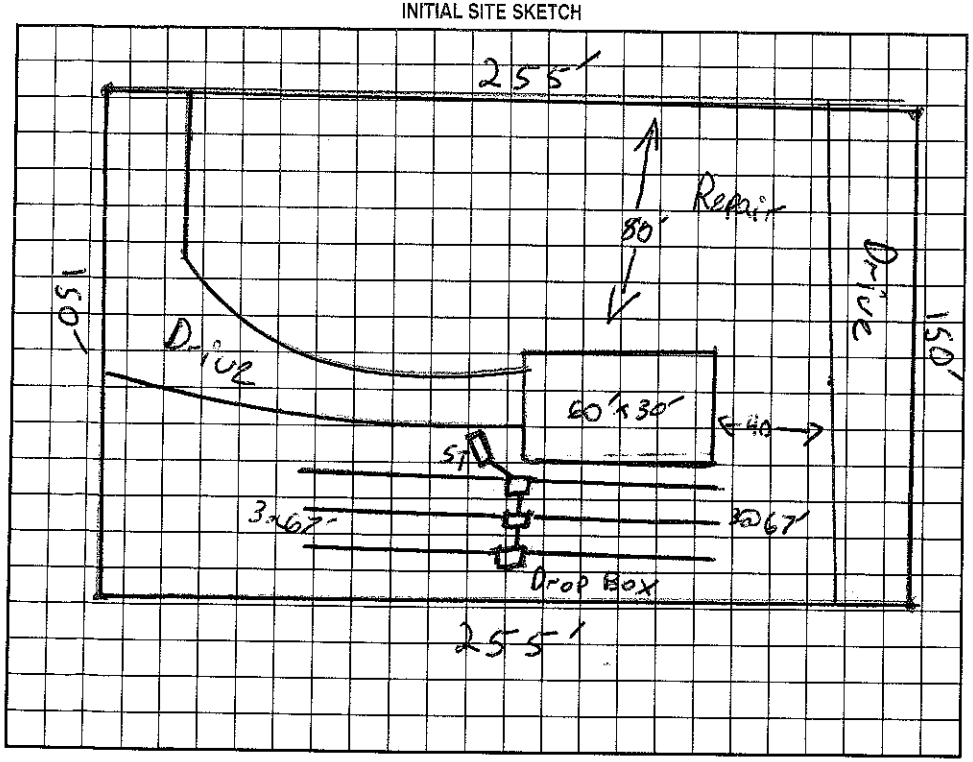

AS BUILT SKETCH

Permit can be suspended or revoked if any false information is supplied toward securing the permit/any unauthorized changes are made to the site/any unauthorized changes are made in the installation of the system. Improvement Permit with plat valid without expiration. Improvement Permit with site plan valid for sixty months. Authorization to Construct is valid ~~for a~~ period equal to that of Improvement Permit – not to exceed sixty months.

Signed: Harold R. Freeze date _____ Installed by: Rowan Septic Tank.

Improvement Permit by: Jeff Morgan date 5/26/99 Operation Permit by: Wesley Sparks RS. date 9/18/01

Authorization to Construct by: Jeff Morgan date 5/26/99 Existing System Inspection by: _____ date _____

HEALTH DEPT. COPY: WHITE OWNER COPY (FINAL): YELLOW OWNER COPY (INITIAL): PINK