IREDELL COUNTY HEALTH DEPARTMENT

Statesville Office (704) 878-5305 Mooresville Office (704) 660-3625 PERMIT # 222960

IMPROVEMENT PERMIT / AUTHORIZATION TO CONSTRUCT / OPERATION PERMIT / EXISTING SYSTEM

PIN # 4770384777 2626

APPLICANT: Freedom Home APPLICANT ADDRESS: 1124 Charlotte Highway Troutman, NC

SITE ADDRESS: 1371 Triplett Rd. Cleveland, NC 27013 PHONE: 704-528-7960 ALT. PHONE: 704-876-5866


SITE DIRECTIONS: US 21 N, turn R on Oswalt Amity, turn R on Triplett Rd.

SUBDIVISION: James W. Hoffner Property SECTION: N/A LOT # 2 LOT AREA: 1.00 AC DESIGN FLOW: 360gpd L.T.A.R.: .25


Septic Tank	1000 (gal)	STB	Date 11-12-16	☑ New System	☐ Repair	☐ Expansion	System Type: I II (III) IV V VI	☑ Residence	No. Bedrooms 3	Water Supply	
Pump Tank	(gal)	PT	Date	System Description: 25% reduction				☐ Business	No. Persons 6	☑ Private	
Pump Make	Model		Serial #	Repair System Description: 50% reduction				☐ Other	No. Employees	☐ Public	
# Nitrification Fields 1	# Lines 3		Linear Ft: 362'	Maintenance Agreement Required:	☐ YES	☑ NO		☐ Slab	☑ Crawl Space	☐ Community	
Trench Width 36"	Max. Trench Bottom Depth 18" low side		Gravel Depth N/A		☑ GRAVITY	☐ PRESSURE		☐ Basement w/ plumbing		☐ Basement w/o plumbing	

Comments / Conditions: Install 25% reduction on contour with serial distribution

INITIAL SITE SKETCH

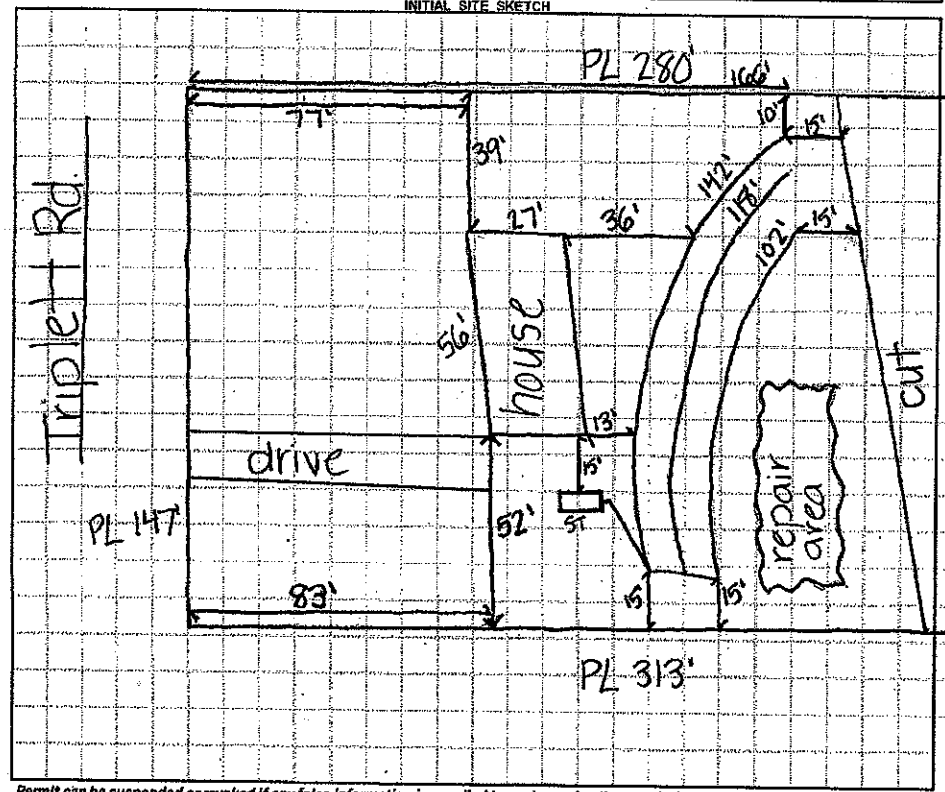

AS BUILT SKETCH

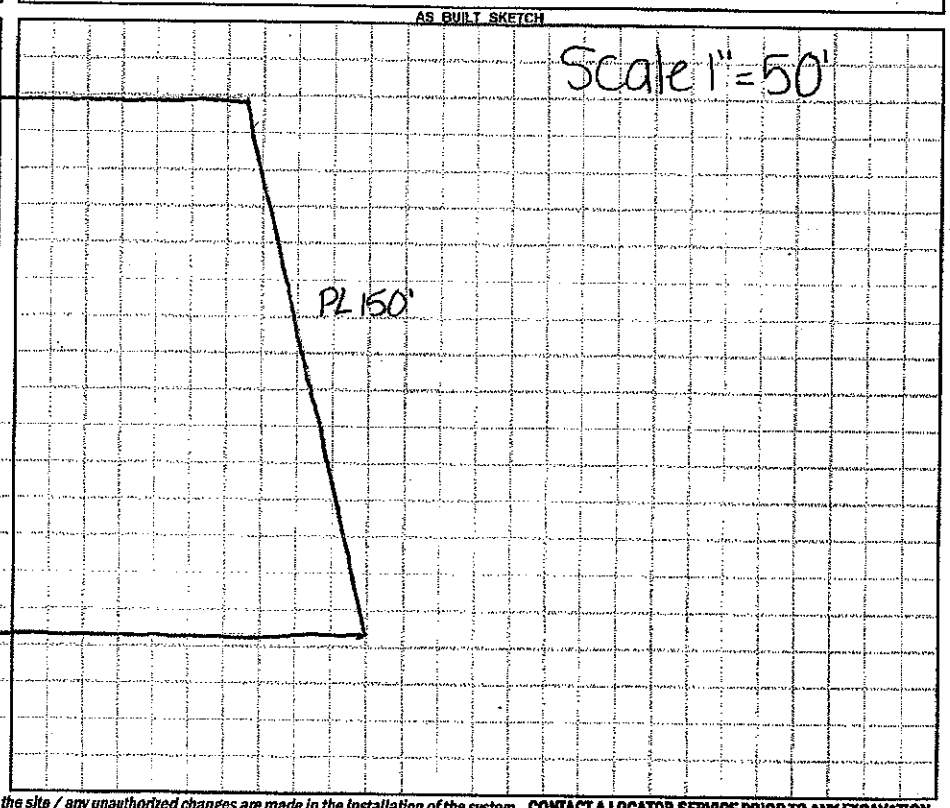

Permit can be suspended or revoked if any false information is supplied toward securing the permit / any unauthorized changes are made to the site / any unauthorized changes are made in the installation of the system. **CONTACT A LOCATOR SERVICE PRIOR TO ANY EXCAVATION**

☐ **IMPROVEMENT PERMIT** *with plat valid without expiration.* ☑ **IMPROVEMENT PERMIT** *with site plan valid for 60 mos.* ☐ **AUTHORIZATION TO CONSTRUCT** *valid for period equal to IMPROVEMENT PERMIT--not to exceed 60 mo.*

Owner / Applicant Signature: Date: 12-9-16 Installed by: CRAIG THOMPSON

IMPROVEMENT PERMIT by: Date: 12/02/16 OPERATION PERMIT by: Date: 1-6-17

AUTHORIZATION TO CONSTRUCT by: Date: 12/9/16 Existing System Inspected by: Date:

Health Dept. Copy - WHITE Applicant (Final Approval) - YELLOW Applicant (Conditional Approval) - PINK