IREDELL COUNTY HEALTH DEPARTMENT

STATESVILLE 704-878-5305 MOORESVILLE 704-664-5281

IMPROVEMENT PERMIT / AUTHORIZATION TO CONSTRUCT / OPERATION PERMIT / EXISTING SYSTEM INSPECTION

PERMIT# 12814p PIN# ~~4770 40 0487~~ 4770400871 DATE 5/30/05

OWNER OR CONTRACTOR Jerry S Bennett PHONE: Business 828-241-3015 Home

ADDRESS 2050 Bethany Rd. Statesville, NC. 28609

LOCATION 801 N TL Turnpike Rd TR French Belk Rd. .7 mile on L

SUBDIVISION No BLOCK / SECTION LOT 0 LOT AREA 2 AC SITE CLASS PS DESIGN FLOW 360 L.T.A.R. .3

Septic Tank: 1000 Gallons; STB Date

Pump Tank: Gallons; PT Date

Pump Make: Model Serial No.

Nitrification Field: No Fields 1 Square Feet 900 Linear Feet 300 ±

No Lines 3@60' Trench Width 3' Max Trench Bottom Depth 3' Gravel Depth No

☒ New System ☐ Repair System Type: I II III IV V VI

System Description: Gravity - 25% Reduced

Repair System Description: 16" PPBS - Pressurized

Maintenance Agreement Required: ☐ Yes ☒ No

☒ House/Mod. Home No. Bedrooms 3

☐ Mobile Home No. Bathrooms 3

☐ Business No. Employees

☐ Other

☐ Slab ☒ Crawl Space ☐ Basement w/plumbing ☐ Basement wo/plumbing


Water Supply: ☒ Individual ☐ Public ☐ Community

Comments:/Conditions: * This is a Accepted System.

Comments:/Conditions:

1" = 100'

INITIAL SITE SKETCH

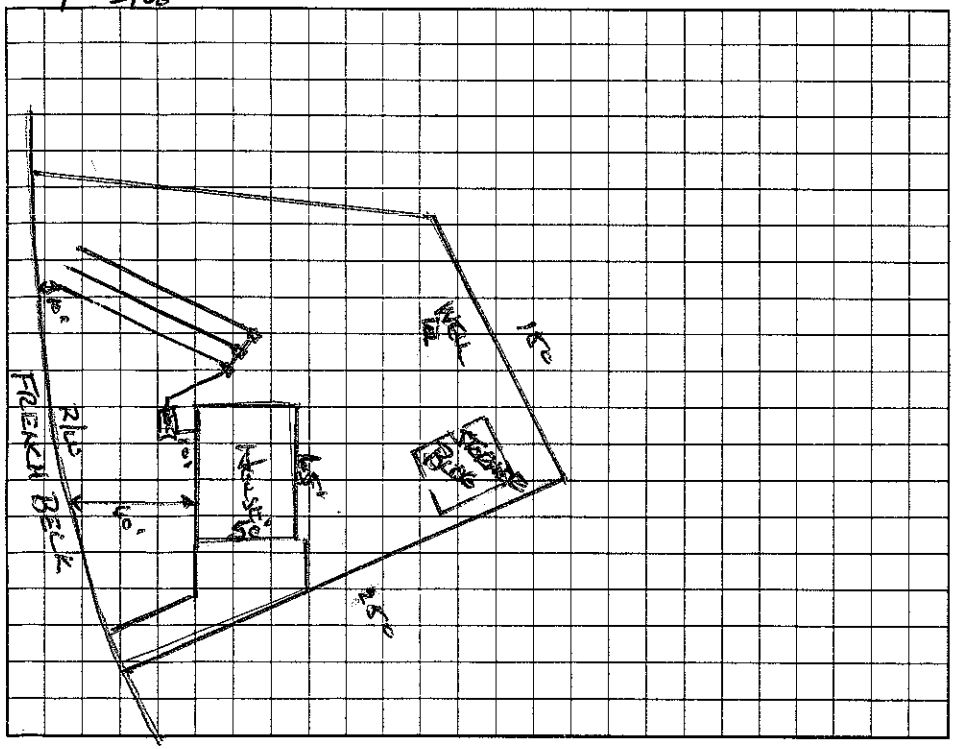

AS BUILT SKETCH

Permit can be suspended or revoked if any false information is supplied toward securing the permit/any unauthorized changes are made to the site/any unauthorized changes are made in the installation of the system. Improvement Permit with plat valid without expiration. Improvement Permit with site plan valid for sixty months. Authorization to Construct is valid for a period equal to that of Improvement Permit – not to exceed sixty months.

Signed: * Jerry S Bennett date 6/2/05 Installed by: Wayne Clontz

Improvement Permit by: Wesley Sparks RS. date 5/30/05 Operation Permit by: Wesley Sparks RS date 8/8/06

Authorization to Construct by: Wesley Sparks RS. date 5/30/05 Existing System Inspection by: date

HEALTH DEPT. COPY: WHITE OWNER COPY (FINAL): YELLOW OWNER COPY (INITIAL): PINK