IREDELL COUNTY HEALTH DEPARTMENT

Authorization To Construct

STATESVILLE 704-878-5305 MOORESVILLE 704-664-5281

IMPROVEMENT PERMIT / ~~CERTIFICATE OF COMPLETION~~ / OPERATION PERMIT / EXISTING SYSTEM INSPECTION

PROPERTY DESCRIPTION NO. 25699 DATE 12/5/96 TAX MAP NO. Pt of 4H 2A 15+16 Watershed: ☐ Yes ☒ No

OWNER OR CONTRACTOR Keith Carroll PHONE: Business 477040 2068 Home 664-1155

ADDRESS 795 French Belk Rd. Mt Ulla NC 28125

LOCATION Confederate Rd TR Cool Creek Ln. on R corner 1st lot

SUBDIVISION Twin Blocks BLOCK / SECTION II LOT 16 LOT AREA .82AC SITE CLASS. PS DESIGN FLOW 360 L.T.A.R. .3

Septic Tank: 1000 Gallons; STB 794 Date 11/29/97

Pump Tank: 1000 Gallons; PT 27 Date 12/2/97

Pump Make: DOULAS Model W20S11H Serial No. L9730804

Nitrification Field: No Fields 1 Square Feet 900 Linear Feet 300

No Lines 3 Trench Width 36" Max Trench Bottom Depth 36" Gravel Depth SAND

☒ New System ☐ Repair System Type: I, II, (III), IV, V, VI

System Description: Pres Man — CH Plastic

Repair System Description: SAME

Maintenance Agreement Required: ☐ Yes ☐ No

☒ House/Mod. Home No. Bedrooms 3

☐ Mobile Home No. Bathrooms 2

☐ Business No. Employees

☐ Other


☐ Slab ☒ Crawl Space ☐ Basement w/plumbing ☐ Basement wo/plumbing

Water Supply: ☒ Individual ☐ Community ☐ Public

Comments:

1"=50'

INITIAL SITE SKETCH

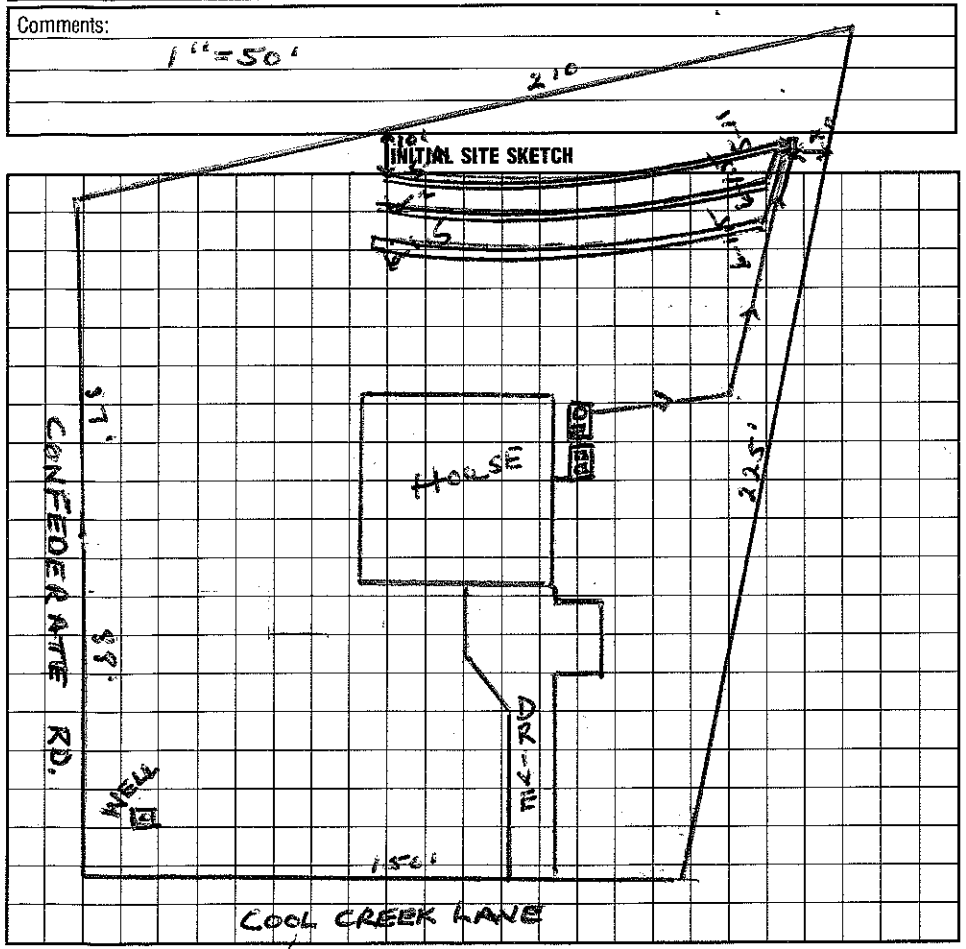

Comments:

AS BUILT SKETCH

I understand that this permit can be suspended or revoked if any false information is supplied toward securing the permit/any unauthorized changes are made to the site/any unauthorized changes are made in the installation of the system.

Signed: Keith Carroll

Improvement Permit by: Wesley Sparks R.S. date 12/5/96

Existing System Inspection by: Wesley Sparks R.S. date 12/5/96

Installed by: F J Erwin

Certificate of Completion by: date

Operation Permit by: C B Teem RS date 3/10/98

Auth To Construct

HEALTH DEPT. COPY: WHITE INSPECTION COPY (FINAL): GREEN OWNER COPY (FINAL): YELLOW INSPECTION COPY (INITIAL): PINK OWNER COPY (INITIAL): GOLD