IREDELL COUNTY HEALTH DEPARTMENT

Authorization to Construct (3/30)

STATESVILLE 704-878-5305 MOORESVILLE 704-664-5281

IMPROVEMENT PERMIT / ~~CERTIFICATE OF COMPLETION~~ / OPERATION PERMIT / EXISTING SYSTEM INSPECTION

PROPERTY DESCRIPTION NO. Kelair DATE 2/26/96 TAX MAP NO. Watershed: ☐ Yes ☒ No

OWNER OR CONTRACTOR Barbara Lyons PHONE: Business Home 664-1880

ADDRESS Connelly Rd Mooresville, NC 28115 PO Box 1734 Mooresville

LOCATION 5th house on (R) past burned house

SUBDIVISION N/A BLOCK / SECTION LOT LOT AREA SITE CLASS. DESIGN FLOW L.T.A.R.

Septic Tank: Existing Gallons; STB Date

Pump Tank: Gallons; PT Date

Pump Make: Model Serial No.

Nitrification Field: No. Fields 1 Square Feet 1200 Linear Feet 400

No. Lines 5 Trench Width 36" Max Trench Bottom Depth 36" Gravel Depth

☐ New System ☒ Repair System Type: I, II, III, IV, V, VI

System Description: Conventional

Repair System Description:

Maintenance Agreement Required: ☐ Yes ☐ No

☐ Slab ☐ Crawl Space ☐ Basement w/plumbing ☐ Basement wo/plumbing

☐ House/Mod. Home No. Bedrooms

☐ Mobile Home No. Bathrooms

☐ Business No. Employees

☐ Other


Water Supply: ☐ Individual ☐ Community ☐ Public

Comments: Paul Hackler - Piedmont Housing


Wood Line

Comments: UPPER LINE CHECKED 12/11/96

INITIAL SITE SKETCH

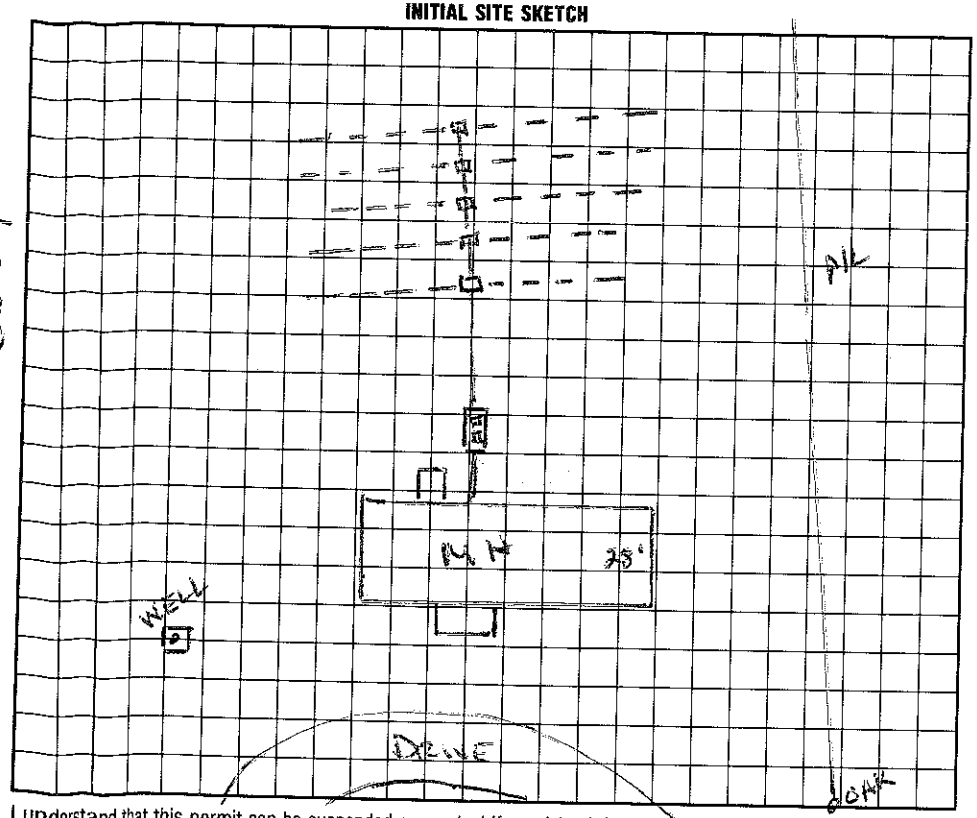

AS BUILT SKETCH

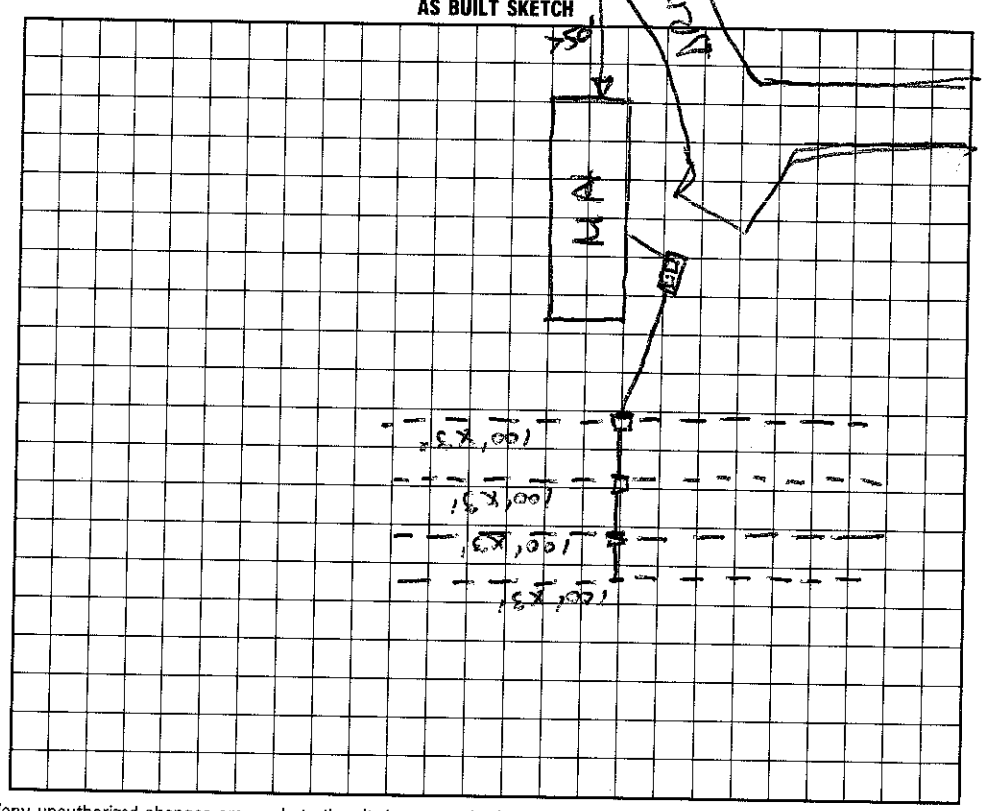

I understand that this permit can be suspended or revoked if any false information is supplied toward securing the permit/any unauthorized changes are made to the site/any unauthorized changes are made in the installation of the system.

Signed: Barbara Lyons

Improvement Permit by: Wesley Sparks RS. date 2/26/96

Existing System Inspection by: Wesley Sparks RS. date 2/26/96

Installed by: Joe Thompson

Certificate of Completion by: Wesley Sparks RS. date 5/12/97

Operation Permit by: Wesley Sparks RS. date 5/12/97

HEALTH DEPT. COPY: WHITE INSPECTION COPY (FINAL): GREEN OWNER COPY (FINAL): YELLOW INSPECTION COPY (INITIAL): PINK OWNER COPY (INITIAL): GOLD