IREDELL COUNTY HEALTH DEPARTMENT

Authorization to Construct 4770404464

STATESVILLE 704-878-5305 MOORESVILLE 704-664-5281

IMPROVEMENT PERMIT / ~~CERTIFICATE OF COMPLETION~~ / OPERATION PERMIT / EXISTING SYSTEM INSPECTION

PROPERTY DESCRIPTION NO. 25701 DATE 12/5/96 TAX MAP NO. Pt of 4H 2 A 15+16 Watershed: ☐ Yes ☒ No

OWNER OR CONTRACTOR Keith Cornell PHONE: Business 664-1155 Home

ADDRESS 795 French Bell Rd. Mt Ulla 28125

LOCATION Confederate Rd TR ~~Cool Creek Lane~~ NEW ROAD PAST COOL CRK CORNER LOT ON (L)

SUBDIVISION TWIN BROOKS BLOCK / SECTION II LOT 25 LOT AREA .81AC SITE CLASS. PS DESIGN FLOW 360 L.T.A.R. .3

Septic Tank: 1000 Gallons; STB 825 Date 3/14/97

Pump Tank: _____ Gallons; PT _____ Date _____

Pump Make: _____ Model _____ Serial No. _____

Nitrification Field: No Fields 1 Square Feet 1200 Linear Feet 400

No Lines 3 Trench Width 36" Max Trench Bottom Depth 36" Gravel Depth 12"

☒ New System ☐ Repair System Type: I, (II), III, IV, V, VI

System Description: D Box - CONVENTIONAL

Repair System Description: CH PLASTIC

Maintenance Agreement Required: ☐ Yes ☒ No

☒ House/Mod. Home No. Bedrooms 3

☐ Mobile Home No. Bathrooms 2

☐ Business No. Employees _____

☐ Other _____

☐ Slab ☒ Crawl Space ☐ Basement w/plumbing ☐ Basement wo/plumbing


Water Supply: ☒ Individual ☐ Community ☐ Public

Comments:

Comments: Gutters to be directed or piped off S/T System.

System installed as shown.

INITIAL SITE SKETCH 1" = 50'

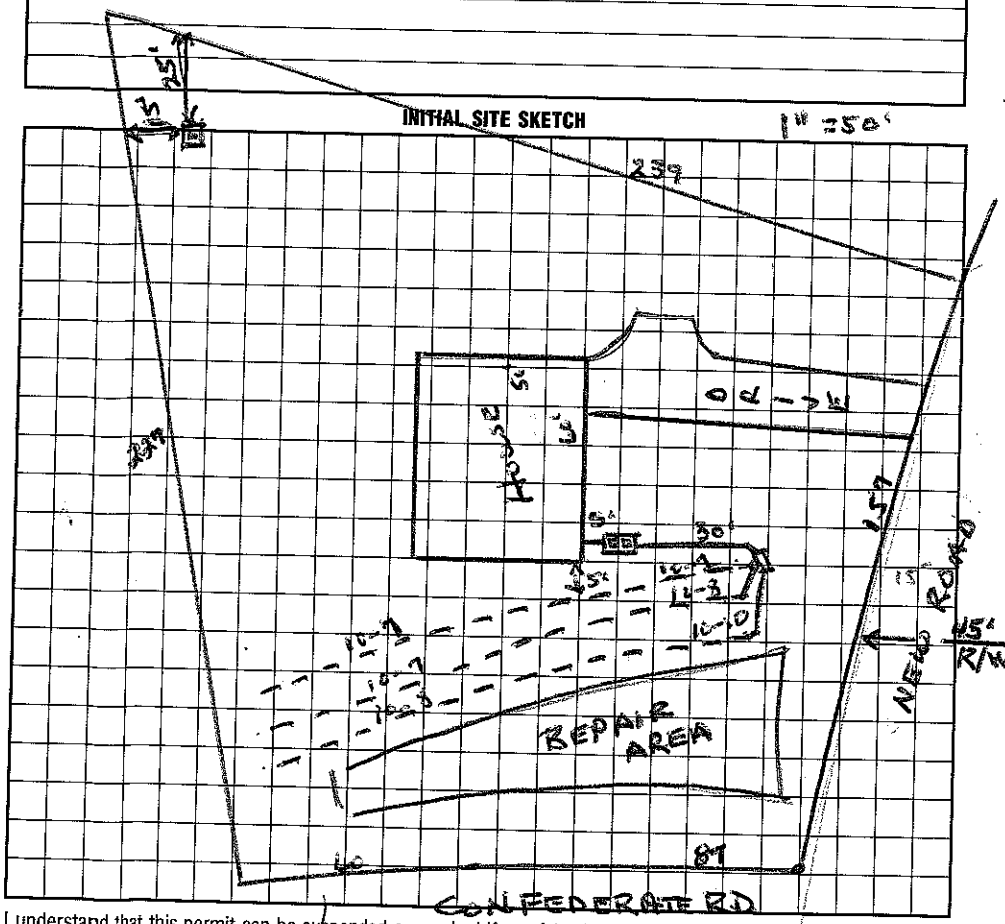

AS BUILT SKETCH

I understand that this permit can be suspended or revoked if any false information is supplied toward securing the permit/any unauthorized changes are made to the site/any unauthorized changes are made in the installation of the system.

Signed: Keith Cornell

Improvement Permit by: Wesley Sparks R.S. date 12/5/96

Existing System Inspection by: Wesley Sparks RS date 12/5/96

Installed by: Bennie Myers

Certificate of Completion by: Wesley Sparks R.S. date 5/12/97

Operation Permit by: Wesley Sparks RS. date 5/12/97

HEALTH DEPT. COPY: WHITE INSPECTION COPY (FINAL): GREEN OWNER COPY (FINAL): YELLOW INSPECTION COPY (INITIAL): PINK OWNER COPY (INITIAL): GOLD