ICHD - ENVIRONMENTAL HEALTH DIVISION

Statesville Office (704) 878-5305 | Mooresville Office (704) 660-3625 | PERMIT # 2023-41004

HS

SEPTIC: IMPROVEMENT PERMIT / AUTHORIZATION TO CONSTRUCT / OPERATION PERMIT / EXISTING SYSTEM

PIN # 4770 -- 46 -- 2288 ✓

APPLICANT/OWNER: Jeanie Lentz | APPLICANT ADDRESS: 463 Lentz Rd, Statesville

SITE ADDRESS: 160 Settlers Haven Rd, Cleveland 27013 ✓ | PHONE: 980-829-3278 | ALT. PHONE -

SITE DIRECTIONS: Triplett - Forest View - Settlers Haven | SAP CONTROLLED: ☐ YES ☐ NO


SUBDIVISION: - | SECTION: - | LOT #: - | LOT AREA: 3.5 acres | DESIGN FLOW: EX | L.T.A.R.: EX

Septic Tank	1000 (gal)	STB	760	Date	9/26/23	☐ New System	☒ Repair	☐ Expansion	System Type: I (II) III IV V VI
Pump Tank	(gal)	PT		Date		System Description:	Tank Replacement		
Pump Make		Model		Serial #		Repair System Description:			
# Nitrification Fields	EX	# Lines	EX	Linear Ft	EX	Maintenance Agreement Required:	☐ YES	☒ NO	
Trench Width	EX	Trench Bottom Depth(Low side)	EX	Gravel Depth	-	☒ GRAVITY	☐ PRESSURE		

☒ Residence	No. Bedrooms	EX	Water Supply	
☐ Business	No. Persons	EX	☒ Private	
☐ Other	No. Employees		☐ Public	
☐ Slab	☐ Crawl Space		☐ Community	
☐ Basement w/plumbing			☒ Basement w/o plumbing	


Comments / Conditions: Pump, crush, & fill old tank. Replace distribution if necessary.

INITIAL SITE SKETCH

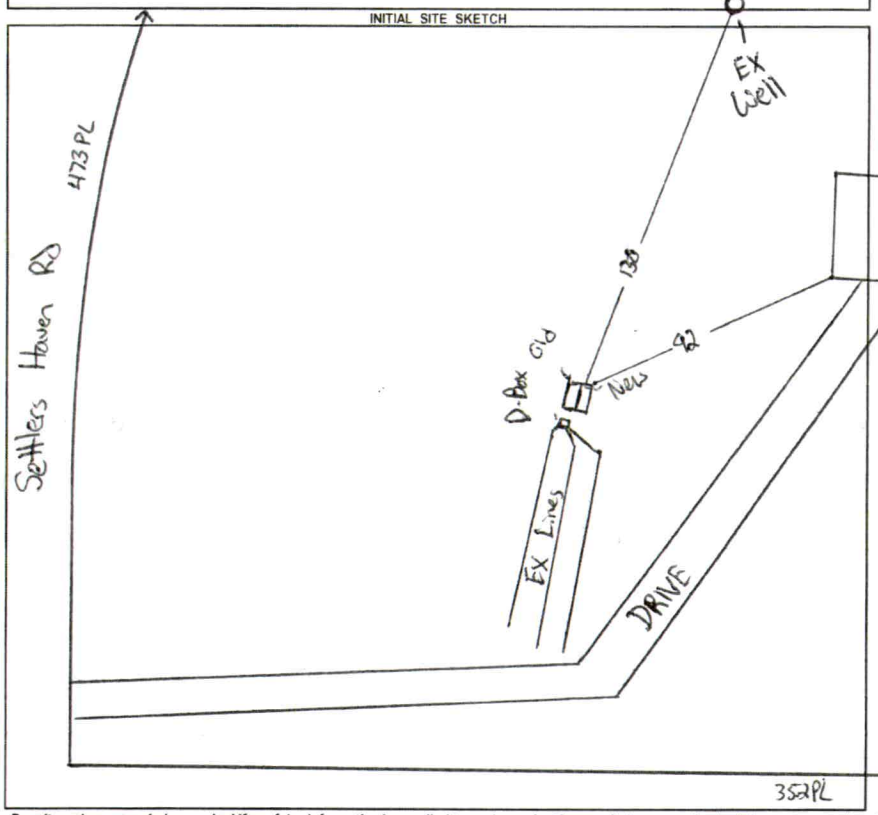

AS BUILT SKETCH

FOR SEPTIC FINAL INSPECTION CALL: 704-664-3703 between 8am-9am the day the inspection is needed. Be sure to speak with an inspector to confirm your time.

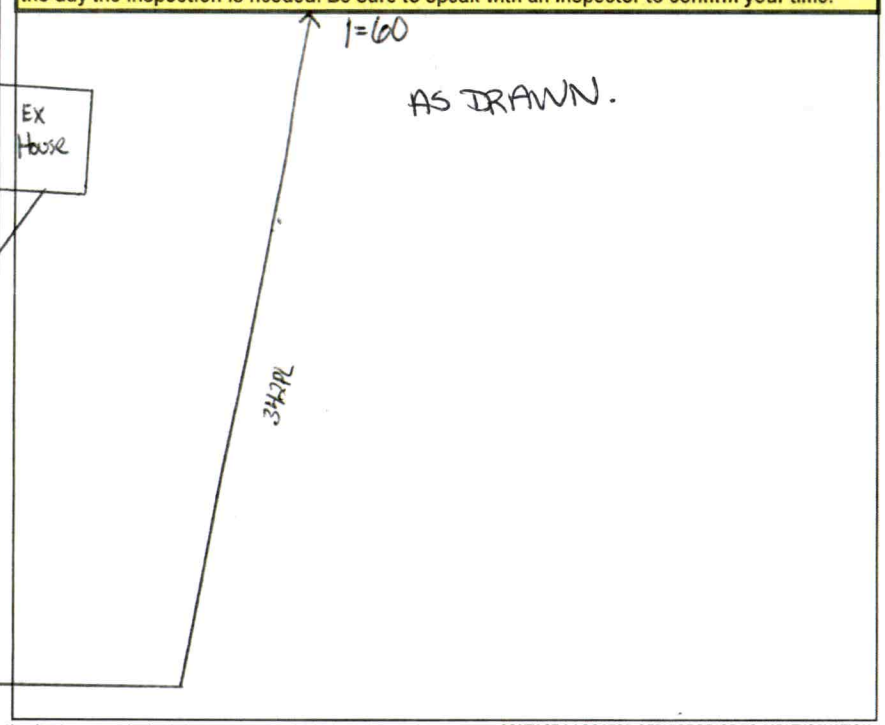

Permit can be suspended or revoked if any false information is supplied toward securing the permit / any unauthorized changes are made to the site / any unauthorized changes are made in the installation of the system. **CONTACT A LOCATOR SERVICE PRIOR TO ANY EXCAVATION**

☐ **IMPROVEMENT PERMIT** ***with plat*** *valid without expiration.* ☒ **IMPROVEMENT PERMIT** ***with site plan*** *valid for 60 mos.* ☒ **AUTHORIZATION TO CONSTRUCT** *valid for period equal to IMPROVEMENT PERMIT--not to exceed 60 mo.*

Owner / Applicant Signature: Online Signature | Date: | Installed by: Lentz Wastewater

IMPROVEMENT PERMIT by: Tony Whit | Date: 11/15/23 | OPERATION PERMIT by: Sarah Williams | Date: 11/29/23

AUTHORIZATION TO CONSTRUCT by: Tony Whit | Date: 11/15/23 | Existing System Inspected by: | Date:

FOR SEPTIC FINAL INSPECTION: CALL 704-664-3703 between 8am-9am the day the inspection is needed.