IREDELL COUNTY HEALTH DEPARTMENT

STATESVILLE 704-878-5305 MOORESVILLE 704-664-5281

IMPROVEMENT PERMIT / AUTHORIZATION TO CONSTRUCT / OPERATION PERMIT / EXISTING SYSTEM INSPECTION

PERMIT # 158008 PIN # 4771-02-1080 DATE 9-11-09

OWNER or APPLICANT TINA SETTLEMYRE PHONE: Business 704-873-2547 ~~Home:~~ CLAYTON HOMES

OWNER or APPLICANT ADDRESS 1582 SHINNVILLE RD CLEVELAND 27013

LOCATION / DIRECTIONS

SUBDIVISION — BLOCK / SECTION — LOT # — LOT AREA .856AC DESIGN FLOW 360 L.T.A.R. .3

Septic Tank EXISTING Gallons: STB Date

Pump Tank Gallons: P T Date

Pump Make Model Serial #

Nitrification Field No Fields 1 No Lines 2 Linear Feet 150'

Trench Width 36" Max. Trench Bottom Depth 36" Gravel Depth —

☐ New System ☐ Repair ☒ Expansion System Type I (II) III IV V VI

System Description: GRAVITY 25% REDUCTION

Repair System Description: SAME

Maintenance Agreement Required ☐ YES ☒ NO

☐ GRAVITY ☐ PRESSURE


☒ Residence No. Bedrooms 3 ☐ Business No. Persons ☐ Other No. Employees ☐ Slab ☒ Crawl Space ☐ Basement w/plumbing ☐ Basement w/o plumbing

Water Supply ☒ Private ☐ Public ☐ Community


Comments / Conditions 1) INSTALL 2 NEW LINES @ 75' EACH ON CONTOUR MEETING ALL SET BACKS 2) SHED + DOGLOT MUST BE MOVED BEFORE INSTALLATION 1"=40'

Comments / Conditions

INITIAL SITE SKETCH

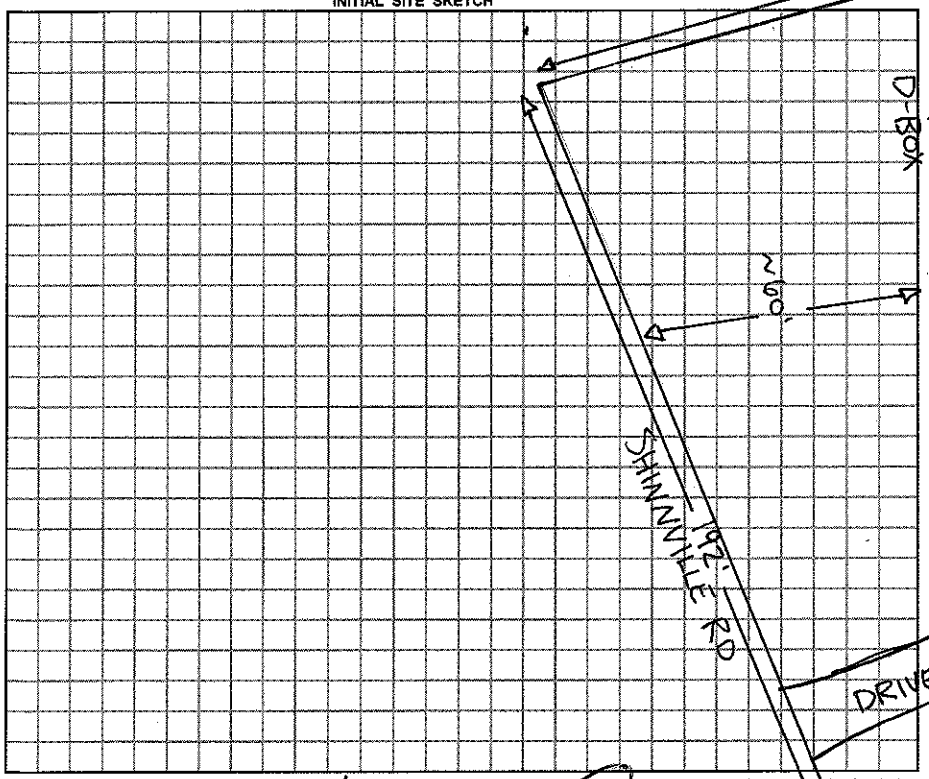

AS BUILT SKETCH

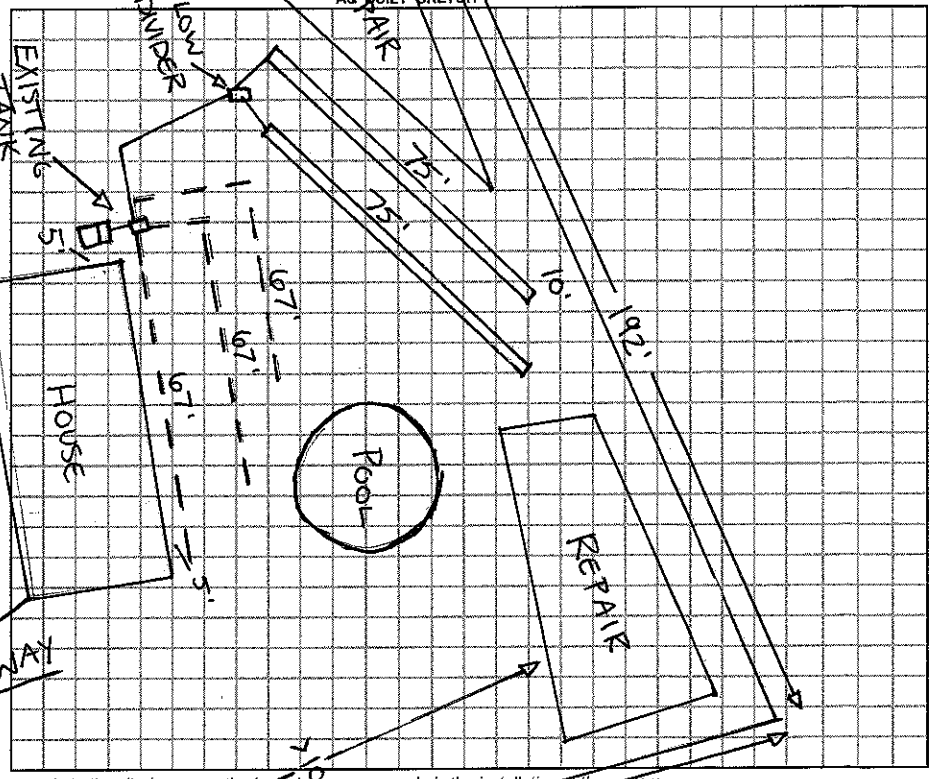

Permit can be suspended or revoked if any false information is supplied toward securing the permit / any unauthorized changes are made to the site / any unauthorized changes are made in the installation of the system.

☐ *IMPROVEMENT PERMIT w / plat valid without expiration.* ☒ *IMPROVEMENT PERMIT w / site plan valid for 60 mos.* ☒ *AUTHORIZATION TO CONSTRUCT valid for period equal to IMPROVEMENT PERMIT-not to exceed 60 mo.*

Owner / Applicant Signature: Date 9-21-09

Improvement Permit by: RS Date 9-11-09

Authorization to Construct by: RS Date 9-11-09

Installed by:

Operation Permit by: RS Date:

Existing System Inspected by: ABEE Date:

YOU SHOULD CONTACT A LOCATOR SERVICE PRIOR TO ANY EXCAVATION.

WHITE COPY Environmental Health YELLOW COPY (Final) Owner / Applicant PINK COPY (Initial) Owner / Applicant