IREDELL COUNTY HEALTH DEPARTMENT

Statesville Phone TR 3-7271 Mooresville Phone NO 3-1271

PERMIT TO INSTALL SEPTIC TANK

Permit NO. _____ Permit Date 1 - 14 - 1960

Owner AMITY, LUTHERAN CHURCH. Address RT. 2 CLEVELAND, N.C.

Installed By STUTTS & BLANTON Address MOORESVILLE, N.C.


Location of Property ABOUT 9 MI. N.E. OUT OF MOORESVILLE AT AMITY.

Tank		Capacity		Length of Lines		Fixtures	
Block	( )	800	(✓)	150'	(✓)	No. of Baths	( )
Precast	(✓)	900	( )	175'	( )	Dishwasher	( )
		1000	( )	200'	( )	Garbage Grdr.	( )
		1100	( )	225'	( )	Auto-Washer	( )
		1200	( )	250'	( )	Other 2 - ½ BATHS	
		Other _____		Other _____			

NOTIFY HEALTH DEPARTMENT AT LEAST EIGHT HOURS BEFORE TANK IS TO BE INSPECTED.

Final Inspection 1 - 14 - 1960 Approved (✓) Disapproved ( )

Remarks INSTALLED 75' DOUBLE DITCH.

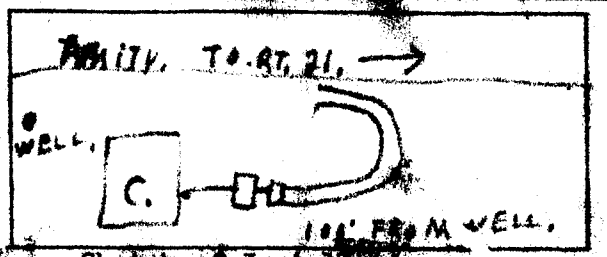

Sketch of Installation

Stutts & Blanton

By. R.L.W. Sanitarian