IREDELL COUNTY HEALTH DEPARTMENT - *ENVIRONMENTAL HEALTH* ☒ STATESVILLE OFFICE 704-878-5305 ☐ MOORESVILLE OFFICE 704-664-5281

IMPROVEMENT PERMIT / AUTHORIZATION TO CONSTRUCT / OPERATION PERMIT / EXISTING SYSTEM INSPECTION

PERMIT # 167640 PIN # 4771090395 DATE 9-26-11

OWNER Terry Martin APPLICANT: House of Prayer & Faith PHONE: Home/Cell # 704-664-2717 Business #

SITE ADDRESS Hemlock Rd. OWNER / APPLICANT ADDRESS 1570 Oakbreeze Dr. Mooresville 28115

SITE DIRECTIONS US 21 to Ostwalt Amity (L) Hemlock ~ 1½ miles on left.

SUBDIVISION n/a BLOCK / SECTION n/a LOT # n/a LOT AREA 1.9 DESIGN FLOW 300 L.T.A.R. .25

Septic Tank 1000 Gallons: STB 700 Date 7-7
Pump Tank ____ Gallons: P T ____ Date ____
Pump Make ____ Model ____ Serial # ____
No. Nitrification Fields: 1 No. Lines 3 Linear Feet 300
Trench Width 36" Max. Trench Bottom Depth 36" Gravel Depth n/a


☒ New System ☐ Repair ☐ Expansion System, Type I II III IV V VI
System Description: 25% Reduction - Gravity
Repair System Description: 25% Reduction - Gravity
Maintenance Agreement Required ☐ YES ☒ NO
☒ GRAVITY ☐ PRESSURE

☐ Residence ☐ Business ☒ Other ☒ Slab ☐ Basement w/plumbing
No. Bedrooms ____ No. Persons 100 No. Employees ____
☐ Crawl Space ☐ Basement w/o plumbing

Water Supply: ☒ Private ☐ Public ☐ Community

Comments / Conditions

INITIAL SITE SKETCH

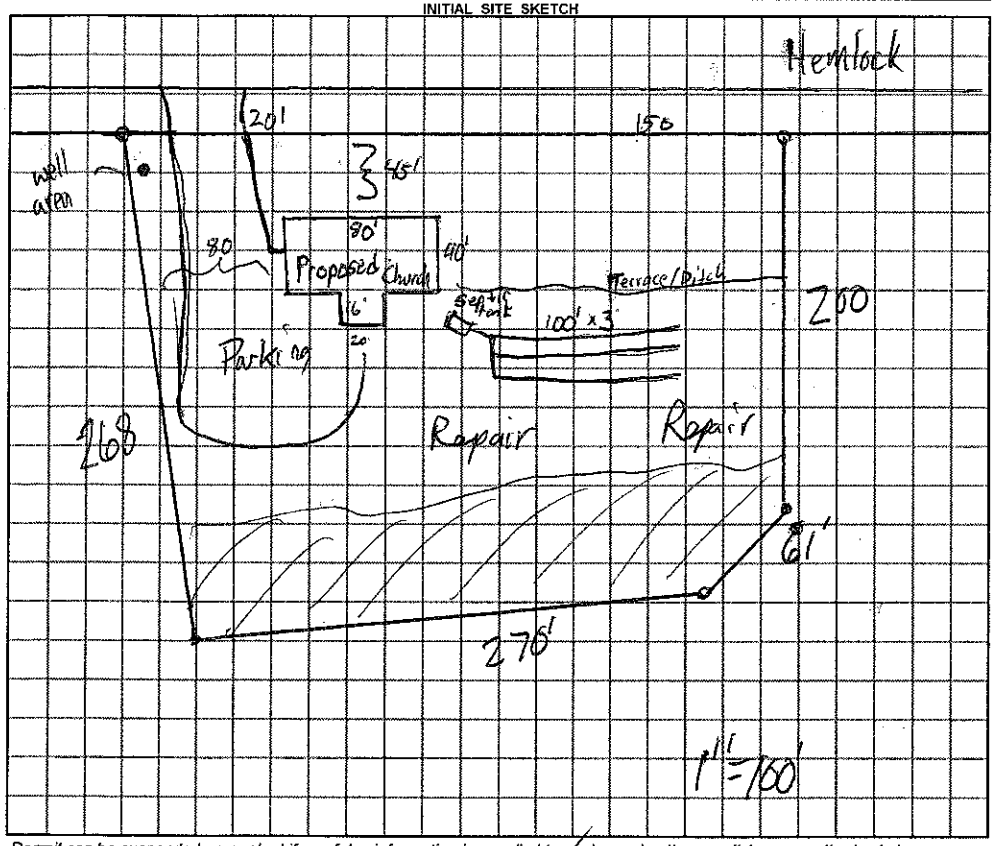

AS BUILT SKETCH

Permit can be suspended or revoked if any false information is supplied toward securing the permit / any unauthorized changes are made to the site / any unauthorized changes are made in the installation of the system.

☐ *IMPROVEMENT PERMIT with plat valid without expiration.* ☒ *IMPROVEMENT PERMIT with ~~plat valid without expiration.~~ site plan valid 60 mo.* ☒ *AUTHORIZATION TO CONSTRUCT* valid for period equal to IMPROVEMENT PERMIT--not to exceed 60 mo.

Owner / Applicant Signature: Terry Martin Date 9-29-11

IMPROVEMENT PERMIT by: James REHS Date 9-26-11

AUTHORIZATION TO CONSTRUCT by: James REHS Date 9-26-11

YOU SHOULD CONTACT A LOCATOR SERVICE PRIOR TO ANY EXCAVATION

Installed by: A-1 Backhoe

OPERATION PERMIT by: James REHS Date 10-5-12

Existing System Inspected by: ____ REHS Date ____

White Copy – Environmental Health YELLOW COPY (Final) Owner / Applicant PINK COPY (Initial) Owner / Applicant