IREDELL COUNTY HEALTH DEPARTMENT

Statesville Phone TR 3-7271 — Mooresville Phone NO 3-1271

PERMIT TO INSTALL SEPTIC TANK

Permit NO. _____ Permit Date 6-20 1958

Owner Rubin Beaver Address Amity Hill

Installed By S Tutt & Blanton Address Box 682, Mooresville


Location of Property Amity Hill

| Tank | | Capacity | | Length of Lines | | Fixtures | |
|---|---|---|---|---|---|---|---|
| Block | ( ) | 800 | (✓) | 150' | (✓) | No. of Baths | (1) |
| Precast | (✓) | 900 | ( ) | 175' | ( ) | Dishwasher | ( ) |
| | | 1000 | ( ) | 200' | ( ) | Garbage Grdr. | ( ) |
| | | 1100 | ( ) | 225' | ( ) | Auto-Washer | ( ) |
| | | 1200 | ( ) | 250' | ( ) | Other | |
| | | Other | | Other | | | |

NOTIFY HEALTH DEPARTMENT AT LEAST EIGHT HOURS BEFORE TANK IS TO BE INSPECTED.

Final Inspection 6-20 1958 Approved (✓) Disapproved ( )

Remarks Installed 25 feet of double ditch

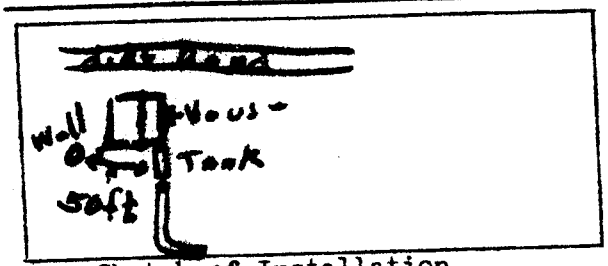


Sketch of Installation

Joe Blanton
(Licensed Contractor)

R-2 Sanitarian