IREDELL COUNTY HEALTH DEPARTMENT - *ENVIRONMENTAL HEALTH* ☒ STATESVILLE OFFICE 704-878-5305 ☐ MOORESVILLE OFFICE 704-664-5281

IMPROVEMENT PERMIT / AUTHORIZATION TO CONSTRUCT / OPERATION PERMIT / EXISTING SYSTEM INSPECTION

PERMIT # Repair PIN # 4771095536 DATE 10/15/12

OWNER Robert Pope APPLICANT: n/a PHONE: Home/Cell # 704 902 4015 Business #

SITE ADDRESS 227 Hemlock Rd. OWNER / APPLICANT ADDRESS

SITE DIRECTIONS 215 Left on Ostwalt Amity, (L) on Hemlock, 5th house on (R) 227 Hemlock

SUBDIVISION n/a BLOCK / SECTION n/a LOT # LOT AREA 3.88 DESIGN FLOW 240 L.T.A.R. 3

Septic Tank 1000 Gallons: STB 760 Date 4-11
Pump Tank Gallons: PT Date
Pump Make Model Serial #
No. Nitrification Fields: 1 No. Lines 3 Linear Feet 200
Trench Width 36" Max. Trench Bottom Depth 36" Gravel Depth n/a

☒ New System ☐ Repair ☐ Expansion System Type I II (III) IV V VI
System Description: 25% Reduction Gravity
Repair System Description: 25% Reduction Gravity
Maintenance Agreement Required ☐ YES ☒ NO
☒ GRAVITY ☐ PRESSURE


☒ Residence No. Bedrooms 2
☐ Business No. Persons
☐ Other No. Employees
☐ Slab ☒ Crawl Space
☐ Basement w/plumbing ☐ Basement w/o plumbing

Water Supply: ☒ Private ☐ Public ☐ Community

Comments / Conditions
1"=60'
Use serial distribution

- Red Poly Lok Filter installed
- A-C 36 installed

INITIAL SITE SKETCH

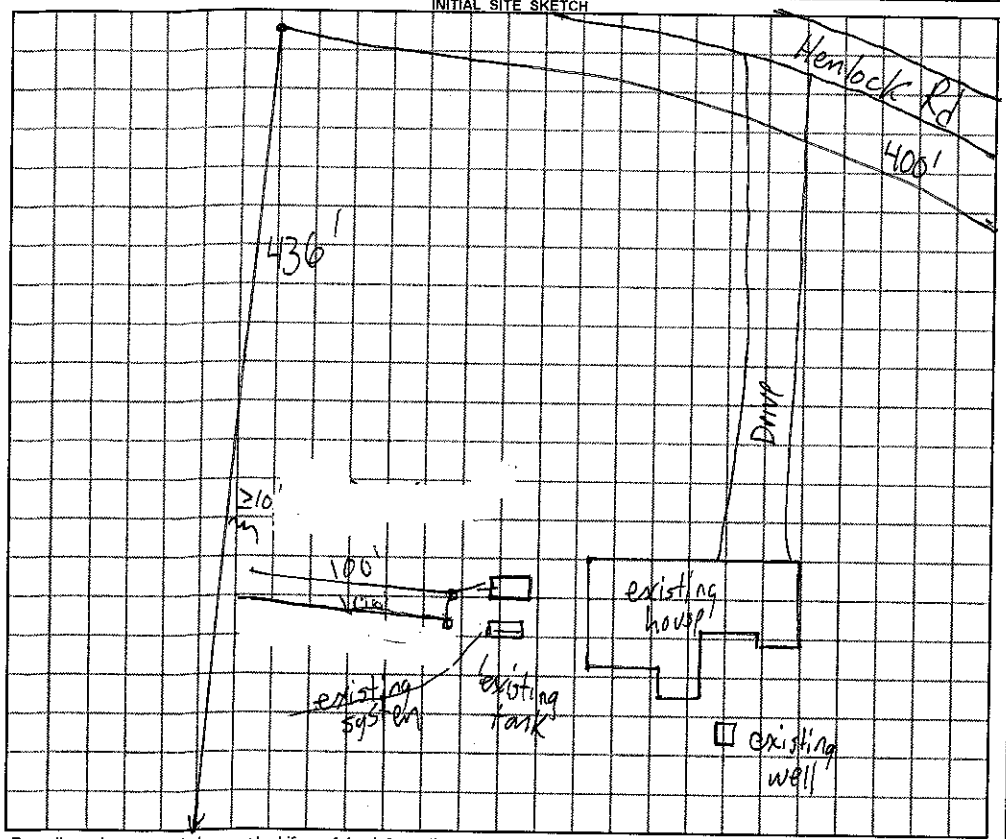

AS BUILT SKETCH

- Installed as drawn

Permit can be suspended or revoked if any false information is supplied toward securing the permit / any unauthorized changes are made to the site / any unauthorized changes are made in the installation of the system.

☐ ***IMPROVEMENT PERMIT*** with plat valid without expiration. ☒ ***IMPROVEMENT PERMIT*** with plat valid without expiration. ***site plan valid 60 mo.*** ☒ ***AUTHORIZATION TO CONSTRUCT*** valid for period equal to IMPROVEMENT PERMIT--not to exceed 60 mo.

Owner / Applicant Signature: Dennis Dallaker Date 10-17-12 Installed by: A1 Backhoe

IMPROVEMENT PERMIT by: REHS Date 10-15-12 OPERATION PERMIT by: Justin Henderson REHS Date 10-19-12

AUTHORIZATION TO CONSTRUCT by: REHS Date 10-15-12 Existing System Inspected by: REHS Date

YOU SHOULD CONTACT A LOCATOR SERVICE PRIOR TO ANY EXCAVATION

White Copy – Environmental Health YELLOW COPY (Final) Owner / Applicant PINK COPY (Initial) Owner / Applicant