Paid 125.00 04 2:00-

IREDELL COUNTY HEALTH DEPARTMENT

STATESVILLE 704-878-5305 MOORESVILLE 704-664-5281

IMPROVEMENT PERMIT / AUTHORIZATION TO CONSTRUCT / OPERATION PERMIT / EXISTING SYSTEM INSPECTION

PERMIT# 091000 PIN# 4771069126 (pt.) DATE August 21, 00

OWNER OR CONTRACTOR DARREN BEAVER PHONE: Business 528-0957 Home

ADDRESS 1028 Triplett Road Cleveland N.C. 27013

LOCATION 115-21 N. TR Ostwalt-Amity Rd. TL Triplett ~1/4 mile on left (East past Pinkford Dr)

SUBDIVISION BLOCK / SECTION LOT LOT AREA 1.5 Ac. SITE CLASS. AS DESIGN FLOW 450 gpd L.T.A.R. 0.5

Septic Tank: 1000 Gallons; STB 1012 Date 6/27/00
Pump Tank: Gallons; PT Date
Pump Make: Model Serial No.
Nitrification Field: No Fields 1 Square Feet 1200 Linear Feet 400
No Lines 5 Trench Width 36" Max Trench Bottom Depth 36"

☒ New System ☐ Repair System Type: I. II. III. IV. V
System Description: Conv. EZE 322 Flow
Repair System Description: 6cm/pump/322 Rel/Trench
Maintenance Agreement Required: ☐ Yes ☒ No
Gravel Depth N/A ☐ Slab ☒ Crawl Space ☐ Basement w/plumbing ☐ Basement wo/plumbing

☒ House/Mod. Home No. Bedrooms 4
☐ Mobile Home No. Bathrooms 2
☐ Business No. Employees
☐ Other


Water Supply: ☒ Individual ☐ Public ☐ Community

Comments/Conditions:

Comments/Conditions:

1" ≈ 100'

INITIAL SITE SKETCH

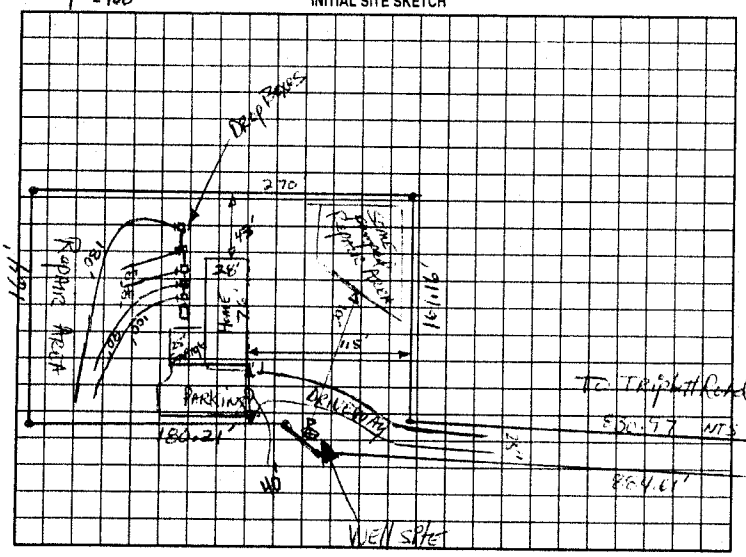

AS BUILT SKETCH

Permit can be suspended or revoked if any false information is supplied toward securing the permit/any unauthorized changes are made to the site/any unauthorized changes are made in the installation of the system. Improvement Permit with plat valid without expiration. Improvement Permit with site plan valid for sixty months. Authorization to Construct is valid for a period equal to that of Improvement Permit – not to exceed sixty months.

Signed: Darren Beaver date 8.22.00

Improvement Permit by: [signature] PS date 8-21-00

Authorization to Construct by: [signature] PS date 8-31-00

Installed by: CRAIG THOMPSON

Operation Permit by: C. Bly date 9/22/00

Existing System Inspection by: date

HEALTH DEPT. COPY: WHITE OWNER COPY (FINAL) YELLOW OWNER COPY (INITIAL) PINK