REDELL COUNTY HEALTH DEPARTMENT

STATESVILLE 704-878-5305 (a) MOORESVILLE 704-664-5281

IMPROVEMENT PERMIT / AUTHORIZATION TO CONSTRUCT / OPERATION PERMIT / EXISTING SYSTEM INSPECTION

PERMIT# 100394 PIN# 4771 19 1176 DATE 8/22/01

OWNER OR CONTRACTOR Charles R. Walters Jr. PHONE: Business _____ Home 664-7579

ADDRESS 111 Kelly Pt. La. Mooresville NC 28117

LOCATION 70 E, R Tripplett, R Hemlock ½ mile on Lt

SUBDIVISION _____ BLOCK / SECTION _____ LOT _____ LOT AREA 80.64 ac. SITE CLASS PS DESIGN FLOW 240 L.T.A.R. 0.5

Septic Tank: 1000 Gallons; STB 825 Date 1-17-04
Pump Tank: _____ Gallons; PT _____ Date _____
Pump Make: _____ Model _____ Serial No. _____
Nitrification Field: No. Fields 1 Square Feet 810 Linear Feet 270
No. Lines 3 @ 90' Trench Width 36" Max Trench Bottom Depth 36"

☒ New System ☐ Repair System Type: I (II) III, IV, V, VI
System Description: Gravity Conventional
Repair System Description: Same
Maintenance Agreement Required: ☐ Yes ☒ No
Gravel Depth 12" ☒ Slab ☐ Crawl Space ☐ Basement w/plumbing ☐ Basement wo/plumbing

☐ House/Mod. Home No. Bedrooms 1
☐ Mobile Home No. Bathrooms 2
☐ Business No. Employees _____
☒ Other Barn


Water Supply: ☒ Individual ☐ Public ☐ Community

Comments:/Conditions:


Comments:/Conditions: ① SYSTEM ALTERED AS SHOWN WITHOUT PRIOR HEALTH DEPARTMENT APPROVAL. ② CHROMA 2 MOTTLES NOTED IN SOIL DURING FINAL INSPECTION ③ SEPTIC TANK WITH MARKER INSTALLED USING "POLYLOK" FILTER

The location of the proposed detached garage addition does not appear to impact the existing septic system. **NOTE:

James REHS
Date: 5-4-11
ICHD-Environmental Health Division

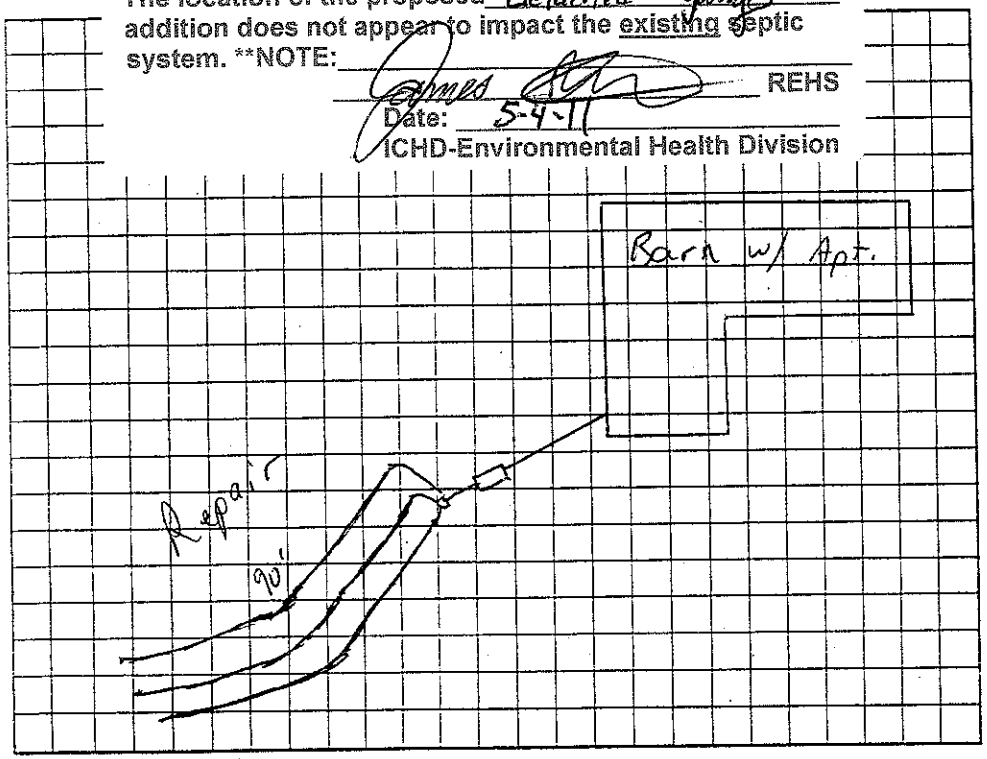

AS BUILT SKETCH

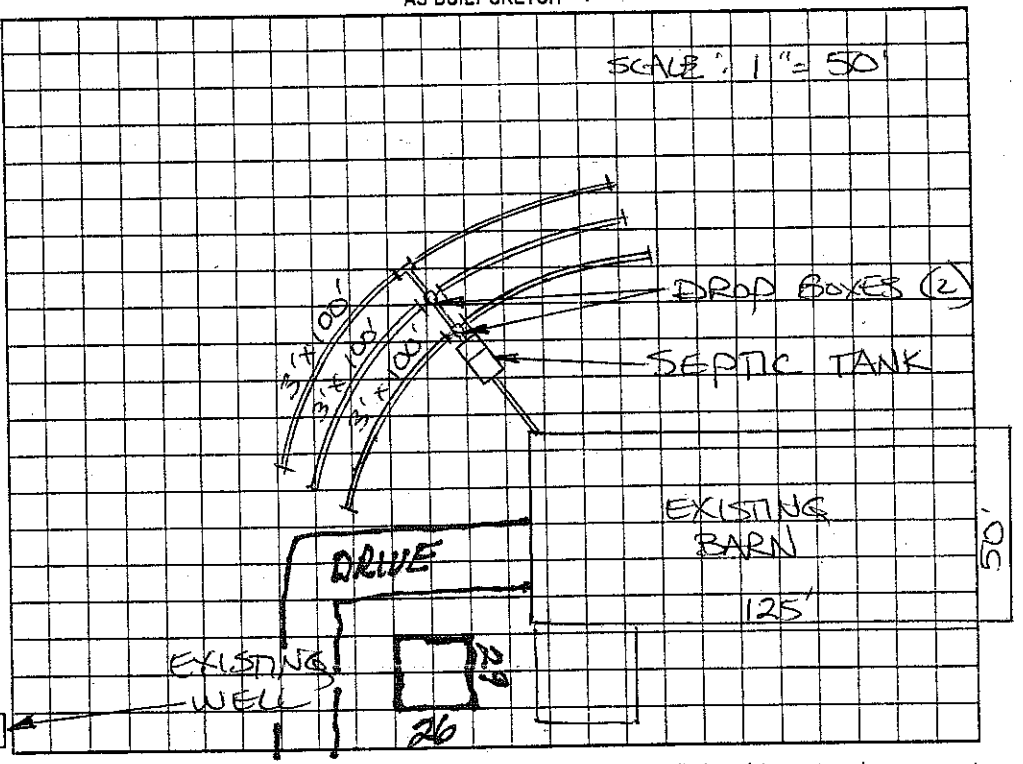

Permit can be suspended or revoked if any false information is supplied toward securing the permit/any unauthorized changes are made to the site/any unauthorized changes are made in the installation of the system. Improvement Permit with plat valid without expiration. Improvement Permit with site plan valid for sixty months. Authorization to Construct is valid for a period equal to that of Improvement Permit – not to exceed sixty months.

Signed: Charles R Walters date 8-23-01

Improvement Permit by: RSI date 8/22/01

Authorization to Construct by: RSE date 8/22/01

Installed by: JST ENTERPRISE

Operation Permit by: STEVE HEDRICK date 3-26-04

Existing System Inspection by: _____ date _____