COPY

Pickedup 2-28-11 jm

IREDELL COUNTY HEALTH DEPARTMENT

STATESVILLE 704-878-5305 MOORESVILLE 704-664-5281

IMPROVEMENT PERMIT / AUTHORIZATION TO CONSTRUCT / OPERATION PERMIT / EXISTING SYSTEM INSPECTION

PERMIT # 127054 PIN # 4771-20-6688 DATE 2-26-11

OWNER or APPLICANT William Hicks PHONE: Business 704-650-1026 Home:

OWNER or APPLICANT ADDRESS 1386 Shearers Rd Mooresville NC 28115

LOCATION / DIRECTIONS 1276 Triplett Rd

SUBDIVISION BLOCK / SECTION LOT # LOT AREA ±10AC DESIGN FLOW 480 L.T.A.R. 2

Septic Tank 1000 Gallons: STB 794 Date 2-16-11

Pump Tank Gallons: P T Date

Pump Make Model Serial #

Nitrification Field No Fields 1 No Lines 5 Linear Feet 600'

Trench Width 36" Max. Trench Bottom Depth 24" Gravel Depth — GRAVITY PRESSURE

☒ New System ☐ Repair ☐ Expansion System Type I II (III) IV V VI

System Description: 25% Reduction

Repair System Description: Same

Maintenance Agreement Required ☐ YES ☒ NO

☒ Residence ☐ Business ☐ Other ☐ Slab ☒ Crawl Space ☐ Basement w/plumbing ☐ Basement w/o plumbing


No. Bedrooms 4 No. Persons No. Employees

Water Supply: ☒ Private ☐ Public ☐ Community


Comments / Conditions 1) Install As Shown 2) Supply Line Must Be >36" Under Drive Way Or Sleeved In Ductile Iron Supply Line Not Under Drive Way

Comments / Conditions

INITIAL SITE SKETCH

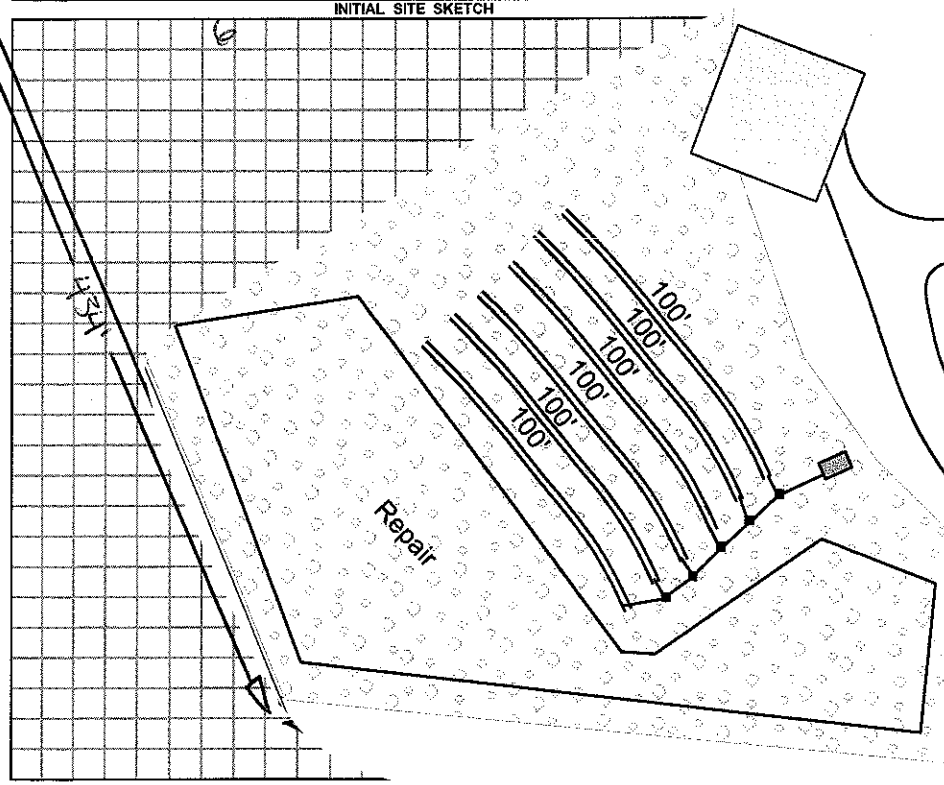

AS BUILT SKETCH

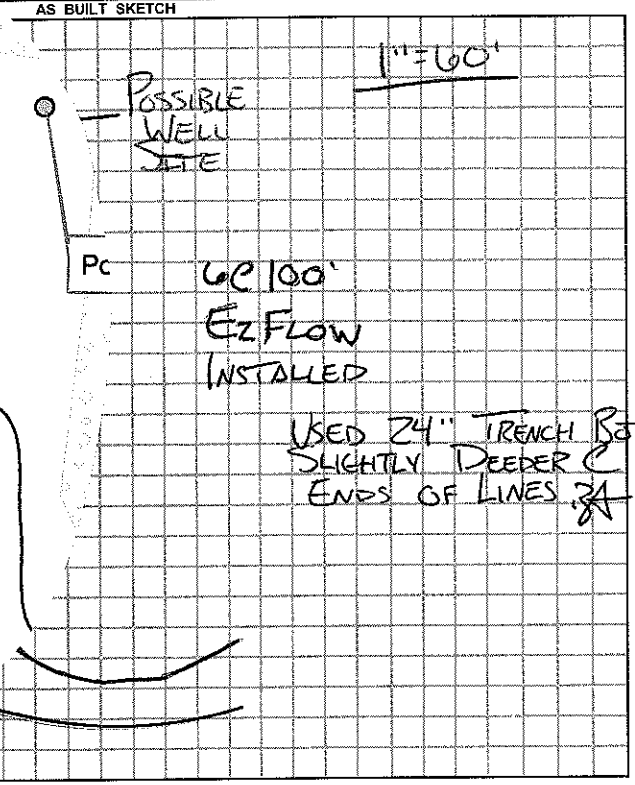

Permit can be suspended or revoked if any false information site / any unauthorized changes are made in the installation of the system.

☐ *IMPROVEMENT PERMIT w / plat valid without expiration.* ☐ IMPROVEMENT PERMIT valid for 60 mos. ☐ *AUTHORIZATION TO CONSTRUCT valid for period equal to IMPROVEMENT PERMIT-not to exceed 60 mo.*

Owner / Applicant Signature: David R. Kelly Jr Date 2-28-11

Improvement Permit by: REHS Date 2-25-11

Authorzation to Construct by: REHS Date 2-25-11

Installed by: R Rhea

Operation Permit by: REHS Date: 4-12-11

Existing System Inspected by: Date:

YOU SHOULD CONTACT A LOCATOR SERVICE PRIOR TO ANY EXCAVATION.

WHITE COPY Environmental Health YELLOW COPY (Final) Owner / Applicant PINK COPY (Initial) Owner / Applicant