Pickedup 2-28-11 gm

IREDELL COUNTY HEALTH DEPARTMENT

STATESVILLE 704-878-5305 MOORESVILLE 704-664-5281

IMPROVEMENT PERMIT / AUTHORIZATION TO CONSTRUCT / OPERATION PERMIT / EXISTING SYSTEM INSPECTION

PERMIT # 27054 PIN # 4771-20-6688 DATE 2-26-11

OWNER or APPLICANT WILLIAM HICKS PHONE: Business 704-650-1026 Home:

OWNER or APPLICANT ADDRESS 1386 SHEARERS RD MOORESVILLE NC 28115

LOCATION / DIRECTIONS 1276 TRIPLETT RD

SUBDIVISION BLOCK / SECTION LOT # LOT AREA ±10AC DESIGN FLOW 480 L.T.A.R. .2

Septic Tank 1000 Gallons: STB 794 Date 2-16-11

Pump Tank Gallons: P T Date

Pump Make Model Serial #

Nitrification Field No Fields 1 No Lines 5 Linear Feet 600'

Trench Width 36" Max. Trench Bottom Depth 24" Gravel Depth —

☒ New System ☐ Repair ☐ Expansion System Type I II (III) IV V VI

System Description: 25% REDUCTION

Repair System Description: SAME

Maintenance Agreement Required ☐ YES ☒ NO

☒ GRAVITY ☐ PRESSURE


☒ Residence No. Bedrooms 4 ☐ Business No. Persons ☐ Other No. Employees ☐ Slab ☒ Crawl Space ☐ Basement w/plumbing ☐ Basement w/o plumbing

Water Supply: ☒ Private ☐ Public ☐ Community


Comments / Conditions 1) INSTALL AS SHOWN 2) SUPPLY LINE MUST BE ≥30" UNDER DRIVE WAY OR SLEEVED IN DUCTILE IRON — SUPPLY LINE NOT UNDER DRIVE WAY

Comments / Conditions

INITIAL SITE SKETCH

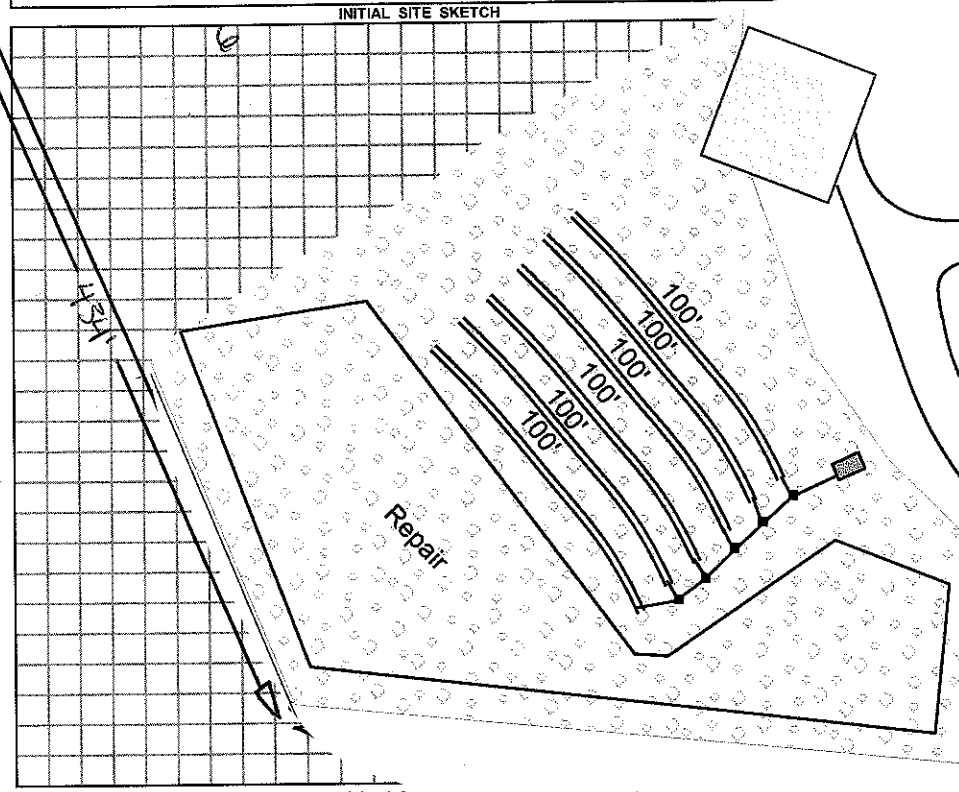

AS BUILT SKETCH

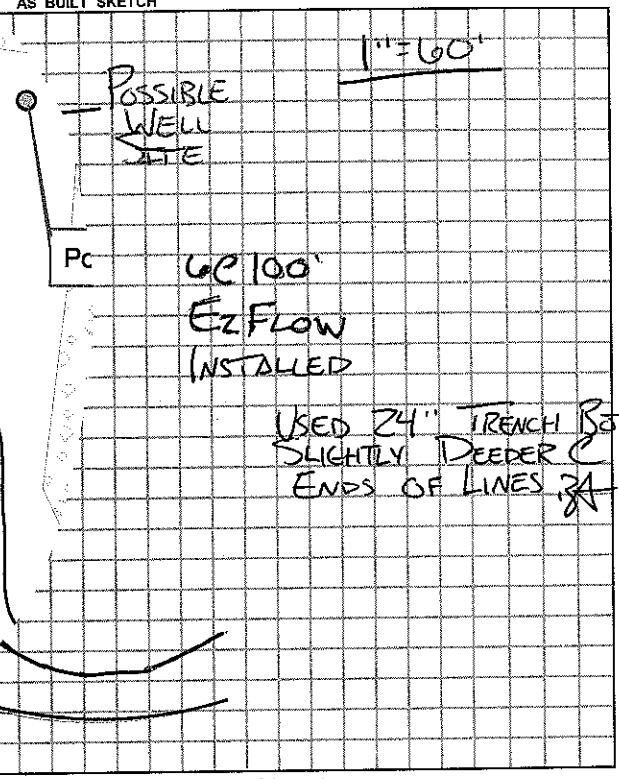

Permit can be suspended or revoked if any false information is given or if any unauthorized changes are made in the installation of the system.

☐ IMPROVEMENT PERMIT w/ plat valid without expiration. ☐ IMPROVEMENT PERMIT valid for 60 mos. ☐ AUTHORIZATION TO CONSTRUCT valid for period equal to IMPROVEMENT PERMIT-not to exceed 60 mo.

Owner / Applicant Signature: David R. Kellogh Date 2-28-11

Improvement Permit by: REHS Date 2-25-11

Authorization to Construct by: REHS Date 2-25-11

Installed by: R HEA

Operation Permit by: REHS Date: 4-12-11

Existing System Inspected by: Date:

YOU SHOULD CONTACT A LOCATOR SERVICE PRIOR TO ANY EXCAVATION.

WHITE COPY Environmental Health YELLOW COPY (Final) Owner / Applicant PINK COPY (Initial) Owner / Applicant