IREDELL COUNTY HEALTH DEPARTMENT

STATESVILLE 704-878-5305 MOORESVILLE 704-664-5281

IMPROVEMENT PERMIT / CERTIFICATE OF COMPLETION / OPERATION PERMIT / EXISTING SYSTEM INSPECTION

PROPERTY DESCRIPTION NO. 19117 DATE 7/1/94 TAX MAP NO. 4J A 21 Watershed: ☐ Yes ☑ No

OWNER OR CONTRACTOR Sidney D Deff. PHONE: Business _____ Home 278-0617

ADDRESS 265 Old County Rd. Cleveland NC. 27013

LOCATION Triplett Rd; Ostensibly TR on Triplett, .7 mi on (R), directly trailer location

SUBDIVISION No BLOCK / SECTION _____ LOT No LOT AREA ~2AC. SITE CLASS. P DESIGN FLOW 360 L.T.A.R. .35 - .35

Septic Tank: 1000 Gallons; STB 825 Date 7/11/94

Pump Tank: _____ Gallons; PT _____ Date _____

Pump Make: _____ Model _____ Serial No. _____

Nitrification Field: No Fields 1 Square Feet 1200 Linear Feet 400

No Lines 4 Trench Width 3' Max Trench Bottom Depth 30" Gravel Depth 12"

☑ New System ☐ Repair System Type: I (II) III, IV, V, VI

System Description: Conv - Dist Box

Repair System Description: GRAVITY PANEL

Maintenance Agreement Required: ☐ Yes ☑ No

☐ House/Mod. Home ☑ Mobile Home ☐ Business ☐ Other

No. Bedrooms 3 No. Bathrooms 2 No. Employees _____


☐ Slab ☑ Crawl Space ☐ Basement w/plumbing ☐ Basement wo/plumbing

Water Supply: ☑ Individual ☐ Community ☐ Public NOT DRILLED

Comments:

Comments: Installed essentially as drawn on Imp. Permit

INITIAL SITE SKETCH

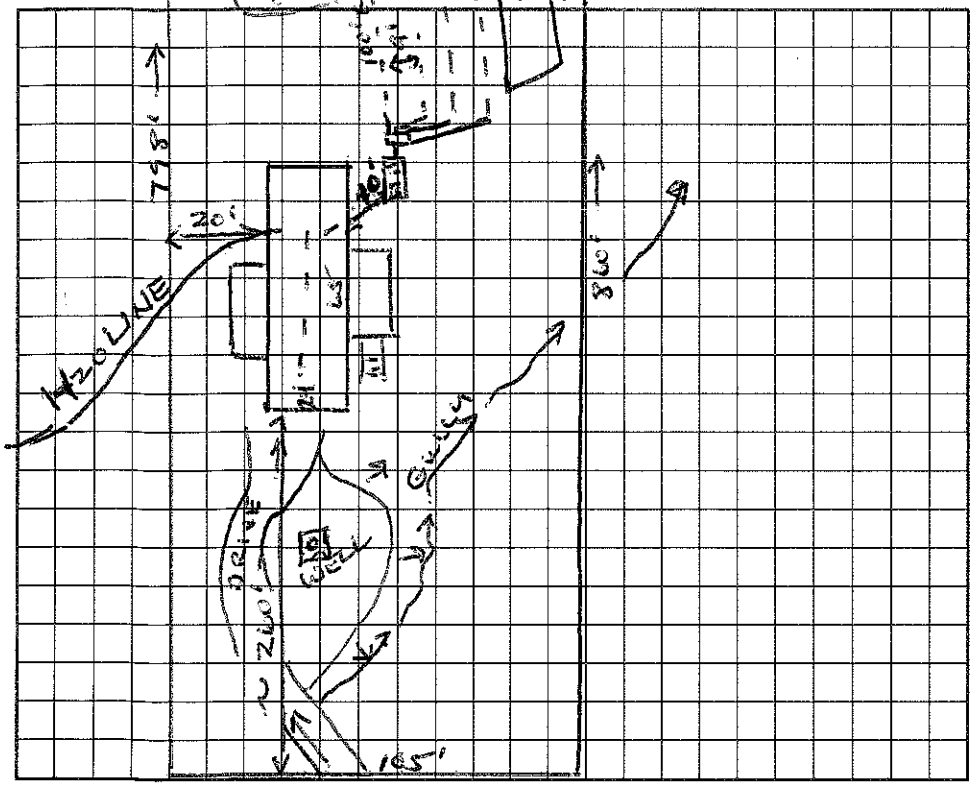

AS BUILT SKETCH

I understand that this permit can be suspended or revoked if any false information is supplied toward securing the permit/any unauthorized changes are made to the site/any unauthorized changes are made in the installation of the system. Improvement Permit is valid for 60 months from date of issuance.

Signed: Glenn Deff

Improvement Permit by: Wesley Sparks RS. date 7/1/94

Existing System Inspection by: _____ date _____

Installed by: Lashatone - 637-0400

Certificate of Completion by: Wesley Sparks RS. date 10/18/94

Operation Permit by: _____ date _____

HEALTH DEPT. COPY: WHITE INSPECTION COPY (FINAL): GREEN OWNER COPY (FINAL): YELLOW INSPECTION COPY (INITIAL): PINK OWNER COPY (INITIAL): GOLD