48124

IREDELL COUNTY HEALTH DEPARTMENT

STATESVILLE 704-878-5305 MOORESVILLE 704-664-5281

IMPROVEMENT PERMIT / CERTIFICATE OF COMPLETION / OPERATION PERMIT / EXISTING SYSTEM INSPECTION

PROPERTY DESCRIPTION NO. 16681 DATE 7-22-93 TAX MAP NO. 5 A-A-67

OWNER OR CONTRACTOR Wayside VFD Inc. PHONE: Business 872-7926 Home

ADDRESS Rt 7 Statesville

LOCATION Corner Triplett Rd + Amity oswalt

SUBDIVISION / BLOCK / SECTION LOT LOT AREA 1.99 acres SITE CLASS. PS L.T.A.R. .28

Water Supply: ☐ Individual ☐ Community ☐ Public

Septic Tank: 1000 Gallons: STB 358 Date 8-13-93

Pump Tank: Gallons: PT Date

Nitrification Field: No Fields 1 Square Feet 900 Linear Feet 300

No Lines 3 Trench Width 36 Trench Depth 24" Gravel Depth 12"

☐ New System ☐ Repair System Type: I. II. III. IV. V. VI

System Description: Conv. Gravity

Repair System Description: " "

Maintenance Agreement Required: ☐ Yes ☐ No

☐ House/Mod. Home ☐ Mobile Home ☐ Business ☐ Other Fire station max. 10 people

No. Bedrooms No. Bathrooms No. Employees

Garbage Disposal: ☐ Yes ☐ No

Auto. Dishwasher: ☐ Yes ☐ No


Auto. Washing Machine: ☐ Yes ☐ No

Other


☐ Slab ☐ Crawl Space ☐ Basement w/plumbing ☐ Basement wo/plumbing

Comments Grass area over drain lines + keep mowed to lawn height

INITIAL SITE SKETCH

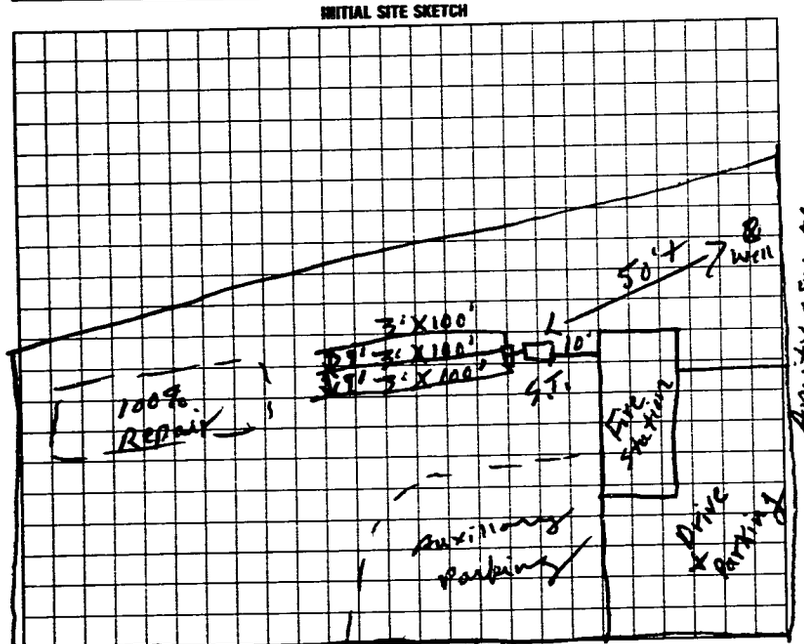

AS BUILT SKETCH

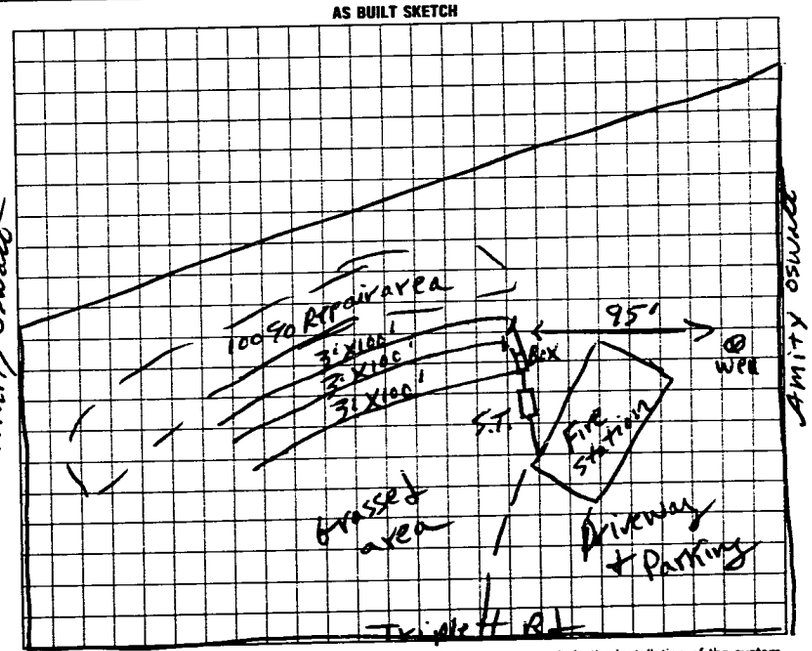

I understand that this permit can be suspended or revoked if any false information is supplied toward securing the permit/any unauthorized changes are made to the site/any unauthorized changes are made in the installation of the system. Improvement Permit is valid for 60 months from date of issuance.

Signed: X

Improvement Permit by: E.C. moore date 7-22-93

Existing System Inspection by: date

Installed by: Donald Jackey

Certificate of Completion by: E.C. moore date 10-13-93

Operation Permit by: date

HEALTH DEPT. COPY: WHITE INSPECTION COPY (FINAL): GREEN OWNER COPY (FINAL): YELLOW INSPECTION COPY (INITIAL): PINK OWNER COPY (INITIAL): GOLD