IREDELL COUNTY HEALTH DEPARTMENT - *ENVIRONMENTAL HEALTH* ☐ STATESVILLE OFFICE 704-878-5305 ☒ MOORESVILLE OFFICE 704-664-5281

IMPROVEMENT PERMIT / AUTHORIZATION TO CONSTRUCT / OPERATION PERMIT / EXISTING SYSTEM INSPECTION

PERMIT # REPAIR PIN # 4771-34-2105 4771-23-7263 DATE 11-23-11

OWNER CHRIS McNEELY APPLICANT: SAME PHONE: Home/Cell # 704-213-3793 Business #

SITE ADDRESS 1496 1568 OSTWALT AMITY RD OWNER / APPLICANT ADDRESS 132 CANTERBERRY DR. SALISBURY NC


SITE DIRECTIONS 801, TRIPPLETT, CORNER OF TRIPP. & OSTWALT AMITY

SUBDIVISION McNeely Family Farm BLOCK / SECTION -1- LOT # 1 LOT AREA 70 Ac DESIGN FLOW 360 L.T.A.R. .2


Septic Tank 1000	Gallons: STB 825	Date 9-11-11	☐ New System	☒ Repair	☐ Expansion System	Type I II (III) IV V VI	☒ Residence	No. Bedrooms 3	Water Supply
Pump Tank	Gallons: P T	Date	System Description:				☐ Business	No. Persons	☒ Private
Pump Make	Model	Serial #	Repair System Description: 25% REDUCTION				☐ Other	No. Employees	☐ Public
No. Nitrification Fields: 1	No. Lines 4	Linear Feet 450'	Maintenance Agreement Required ☐ YES ☒ NO				☐ Slab	☒ Crawl Space	☐ Community
Trench Width 36"	Max. Trench Bottom Depth 36"		Gravel Depth —	☒ GRAVITY	☐ PRESSURE		☒ Basement w/plumbing	☐ Basement w/o plumbing	

Comments / Conditions

INITIAL SITE SKETCH

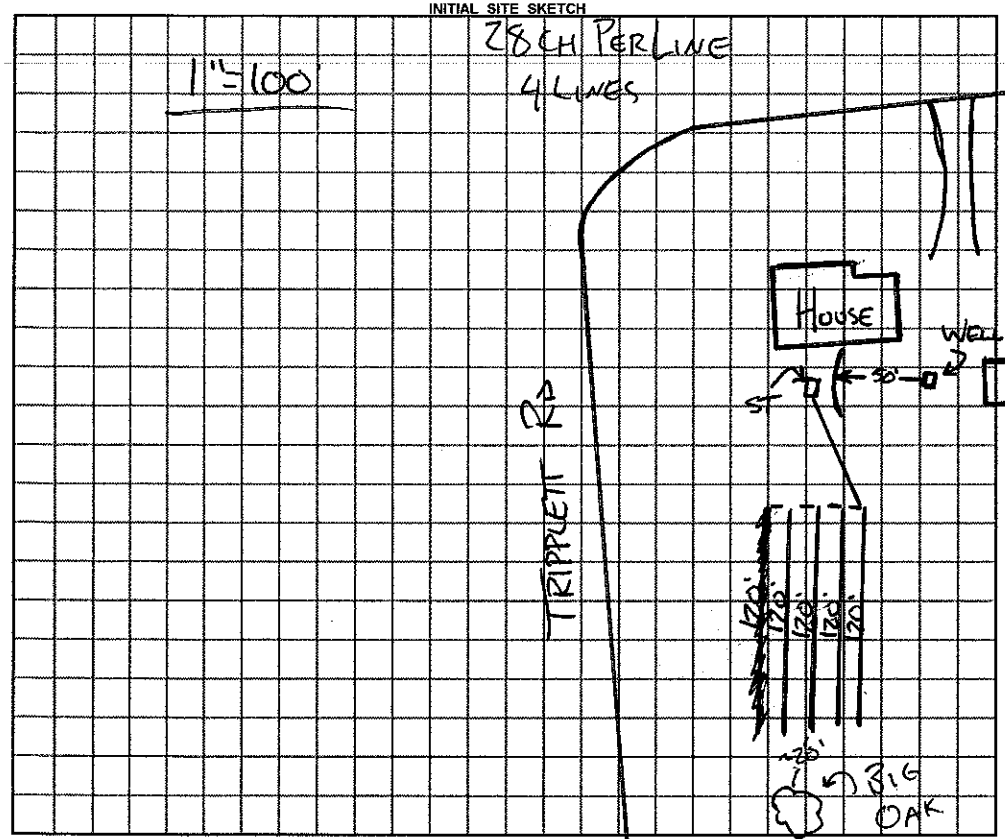

AS BUILT SKETCH

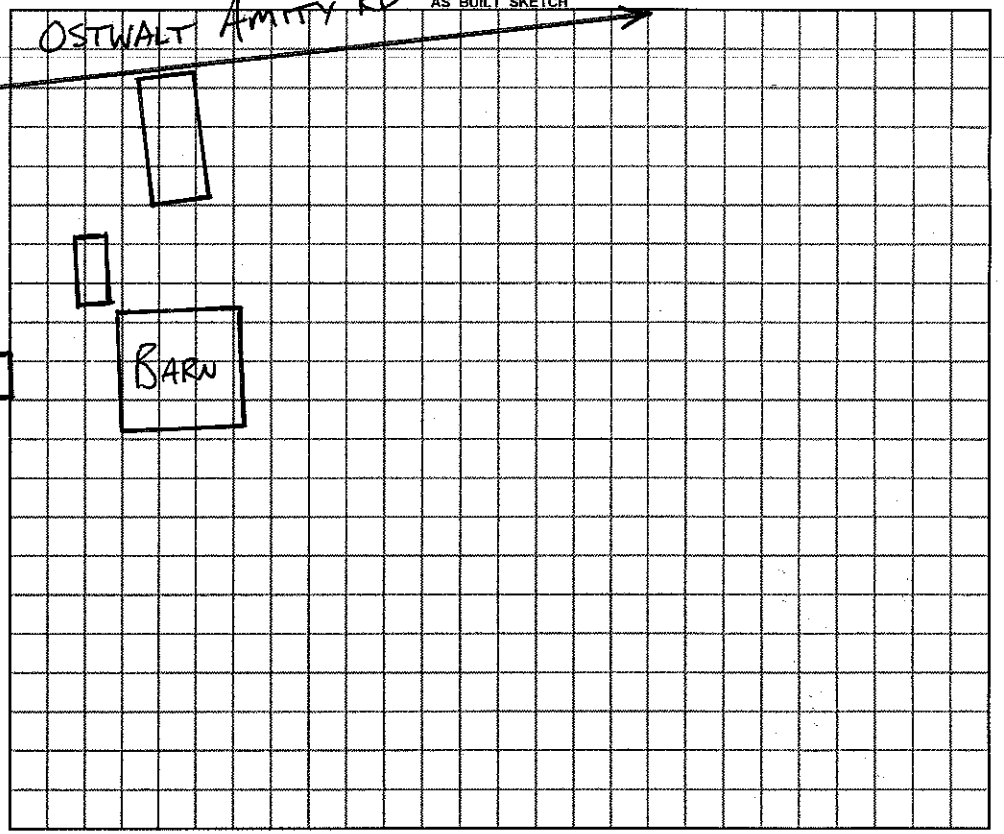

Permit can be suspended or revoked if any false information is supplied toward securing the permit / any unauthorized changes are made to the site / any unauthorized changes are made in the installation of the system.

☐ ***IMPROVEMENT PERMIT*** with plat valid without expiration. ☐ ***IMPROVEMENT PERMIT*** with plat valid without expiration, site plan valid 60 mo. ☒ ***AUTHORIZATION TO CONSTRUCT*** valid for period equal to IMPROVEMENT PERMIT--not to exceed 60 mo.

Owner / Applicant Signature: Chris McNeely Date 11-28-2011 Installed by: ROWAN SEPTIC

IMPROVEMENT PERMIT by: REHS Date 11-23-11 OPERATION PERMIT by: REHS Date

AUTHORIZATION TO CONSTRUCT by: REHS Date 11-23-11 Existing System Inspected by: REHS Date

YOU SHOULD CONTACT A LOCATOR SERVICE PRIOR TO ANY EXCAVATION

White Copy – Environmental Health YELLOW COPY (Final) Owner / Applicant PINK COPY (Initial) Owner / Applicant