IREDELL COUNTY HEALTH DEPARTMENT

Statesville Office (704) 878-5305 Mooresville Office (704) 660-3625 PERMIT # 212153

IMPROVEMENT PERMIT / AUTHORIZATION TO CONSTRUCT / OPERATION PERMIT / EXISTING SYSTEM

PIN # 4771342165 ~~000~~ 23-7263

APPLICANT: Gary Burgess APPLICANT ADDRESS: 1496 Ostwalt Amity Cleveland NC 27013

SITE ADDRESS: 1496 Ostwalt Amity Cleveland NC 27013 PHONE: 704-798-4180 ALT. PHONE:

SITE DIRECTIONS: Hwy 115 Turn on Mazeppa, R Triplett, Site on Corner of Triplett And Ostwalt Amity.

SUBDIVISION: McNeely Family Farm LLC SECTION: LOT # Tract 1 LOT AREA: 3.8422 Acre DESIGN FLOW: Ex. 360 GPD T.A.R.: Existing

Septic Tank Existing (gal)	STB	Date	☐ New System ☐ Repair ☐ Expansion System Type: I II (III) IV V VI		☒ Residence	No. Bedrooms Ex 3	Water Supply
Pump Tank (gal)	PT	Date	System Description: Existing Conventional		☐ Business	No. Persons Ex 6	☒ Private
Pump Make	Model	Serial #	Repair System Description: Existing 25% Reduction-GW		☐ Other	No. Employees	☐ Public
# Nitrification Fields Ex	# Lines Ex 4	Linear Ft: Ex	Maintenance Agreement Required: ☐ YES ☒ NO		☐ Slab	☐ Crawl Space	☐ Community
Trench Width Ex	Max. Trench Bottom Depth Ex	Gravel Depth Ex	☒ GRAVITY ☐ PRESSURE		☒ Basement w/plumbing		☒ Basement w/o plumbing


Comments / Conditions: Permit is for 40' x 24' Garage.

Existing Septic Appears To Be Functioning @ Time of Inspection.

INITIAL SITE SKETCH

1" = 80'

AS BUILT SKETCH

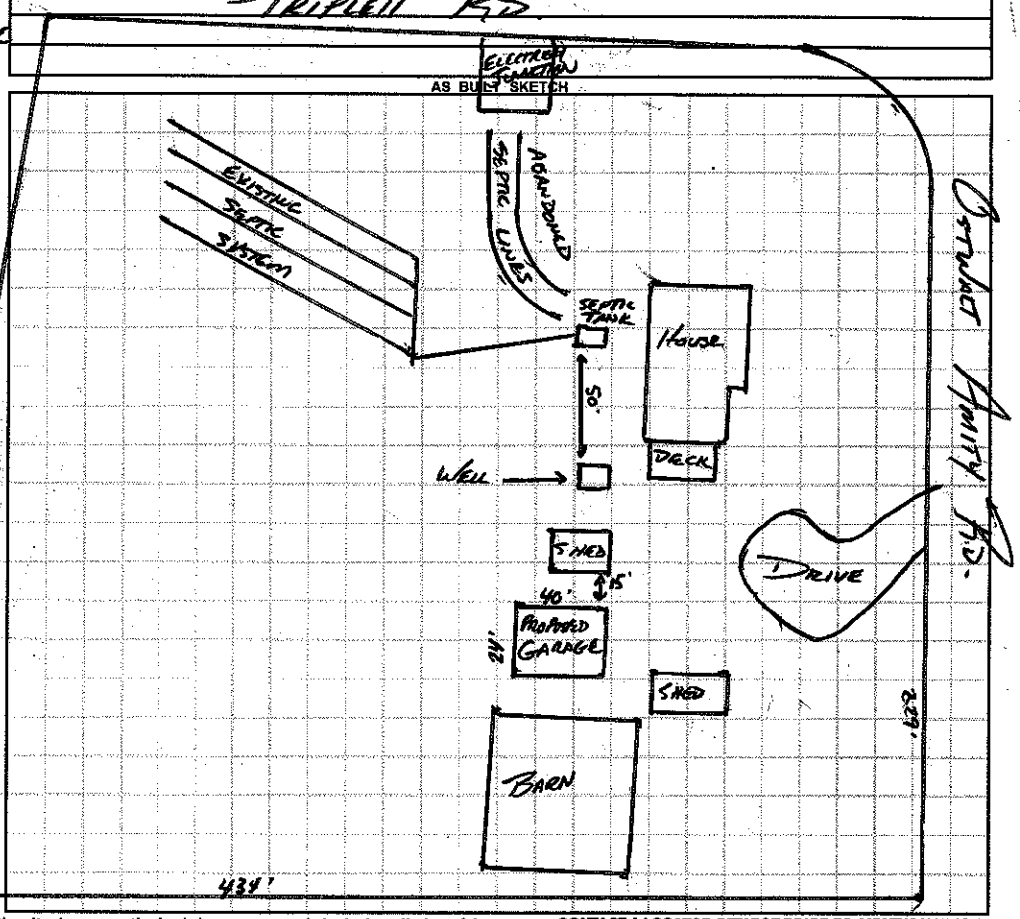

Permit can be suspended or revoked if any false information is supplied toward securing the permit / any unauthorized changes are made to the site / any unauthorized changes are made in the installation of the system. **CONTACT A LOCATOR SERVICE PRIOR TO ANY EXCAVATION**

☐ **IMPROVEMENT PERMIT** *with plat valid without expiration.* ☐ **IMPROVEMENT PERMIT** *with site plan valid for 60 mos.* ☐ **AUTHORIZATION TO CONSTRUCT** *valid for period equal to IMPROVEMENT PERMIT--not to exceed 60 mo.*

Owner / Applicant Signature: Gary Burgess Date: 8-24-15 Installed by:

IMPROVEMENT PERMIT by: Date: OPERATION PERMIT by: Date:

AUTHORIZATION TO CONSTRUCT by: Date: Existing System Inspected by: Date: APPROVED AUG 12 2015

Health Dept. Copy - WHITE Applicant (Final Approval) - YELLOW Applicant (Conditional Approval) - PINK