IREDELL COUNTY HEALTH DEPARTMENT

STATESVILLE 704-878-5305 MOORESVILLE 704-664-5281 52621

IMPROVEMENT PERMIT / CERTIFICATE OF COMPLETION / OPERATION PERMIT / EXISTING SYSTEM INSPECTION

PROPERTY DESCRIPTION NO. 18799 DATE 7-27-94 TAX MAP NO. 5F-2-A-56

OWNER OR CONTRACTOR Acerage Investments PHONE: Business 532-6520 Home

ADDRESS 5551 Monroe Rd Charlotte, NC 28212 Watershed: ☐ Yes ☒ No

LOCATION 70E TR Triplett Rd TL Waterwood Dr. 4th lot on left

SUBDIVISION Willow Ridge BLOCK / SECTION LOT 56 LOT AREA 1.8 acres SITE CLASS. PS DESIGN FLOW 360 L.T.A.R. .35

Septic Tank: 1000 Gallons; STB 1012 Date 6/8/94

Pump Tank: 1000 Gallons; PT 188 Date 5-23-94

Pump Make: Goulds Model 3885 Serial No. INE 101214

Nitrification Field: No Fields 1 Square Feet 1050 Linear Feet 350

No Lines 5 Trench Width 36" Max Trench Bottom Depth 24" Gravel Depth 12"

☒ New System ☐ Repair System Type: I, II, III, IV, V, VI

System Description: Pump To conv. lines

Repair System Description: " " " "

Maintenance Agreement Required: ☐ Yes ☒ No

☐ House/Mod. Home No. Bedrooms 3

☒ Mobile Home No. Bathrooms 2

☐ Business No. Employees

☐ Other

☐ Slab ☒ Crawl Space ☐ Basement w/plumbing ☐ Basement wo/plumbing


Water Supply: ☒ Individual ☐ Community ☐ Public

IHP

Comments: use Pump That will deliver 40 gal/min at 25' Total Head

Comments:

INITIAL SITE SKETCH See Attached Sheets for Pump Tank & manifold set up

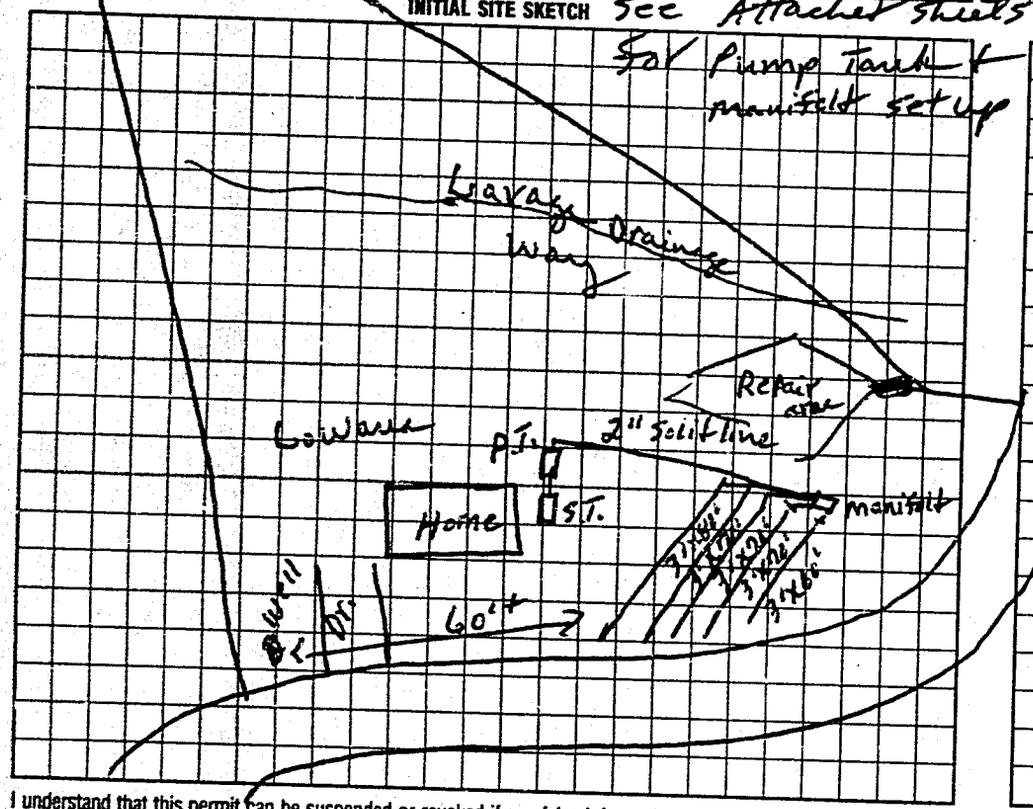

AS BUILT SKETCH

Same as initial Sketch

I understand that this permit can be suspended or revoked if any false information is supplied toward securing the permit/any unauthorized changes are made to the site/any unauthorized changes are made in the installation of the system. Improvement Permit is valid for 60 months from date of issuance.

Signed: James J Burkley

Improvement Permit by: R.C. Moore date 7-27-94

Existing System Inspection by: _____ date _____

Installed by: Andy Daniels

Certificate of Completion by: R.C. Moore date 9-29-94

Operation Permit by: _____ date _____

HEALTH DEPT. COPY: WHITE INSPECTION COPY (FINAL): GREEN OWNER COPY (FINAL): YELLOW INSPECTION COPY (INITIAL): PINK OWNER COPY (INITIAL): GOLD