IREDELL COUNTY HEALTH DEPARTMENT

STATESVILLE 704-878-5305 MOORESVILLE 704-664-5281

IMPROVEMENT PERMIT / AUTHORIZATION TO CONSTRUCT / OPERATION PERMIT / EXISTING SYSTEM INSPECTION

PERMIT# 86190 PIN# 4771338634 DATE 11-22-99

OWNER OR CONTRACTOR Thomas Mahala PHONE: Business 878 3420 Home -

ADDRESS 1553 Oswalt Amity Rd Cleveland N.C.

LOCATION 70E TR Triplett Th Oswalt Amity 1/4mi left

SUBDIVISION _____ BLOCK / SECTION _____ LOT _____ LOT AREA 1.3 acres SITE CLASS PS DESIGN FLOW 480 L.T.A.R. .4

Septic Tank: 1000 Gallons; STB 1012 Date 7-30-99
Pump Tank: _____ Gallons; PT _____ Date _____
Pump Make: _____ Model _____ Serial No _____
Nitrification Field: No Fields 1 Square Feet 1200 Linear Feet 400
No Lines 4 Trench Width 36" Max Trench Bottom Depth 36" Gravel Depth 12"

☑ New System ☐ Repair System Type: ☐ I ☑ III, IV, V, VI
System Description: Conv. Gravity
Repair System Description: " "
Maintenance Agreement Required: ☐ Yes ☑ No

☑ House/Mod. Home No. Bedrooms 4
☐ Mobile Home No. Bathrooms 2½
☐ Business No. Employees _____
☐ Other _____


☐ Slab ☑ Crawl Space ☐ Basement w/plumbing ☐ Basement wo/plumbing

Water Supply: ☑ Individual ☐ Public ☐ Community


Comments:/Conditions:
Replacing Ex House + S.T. System

Comments:/Conditions:

INITIAL SITE SKETCH

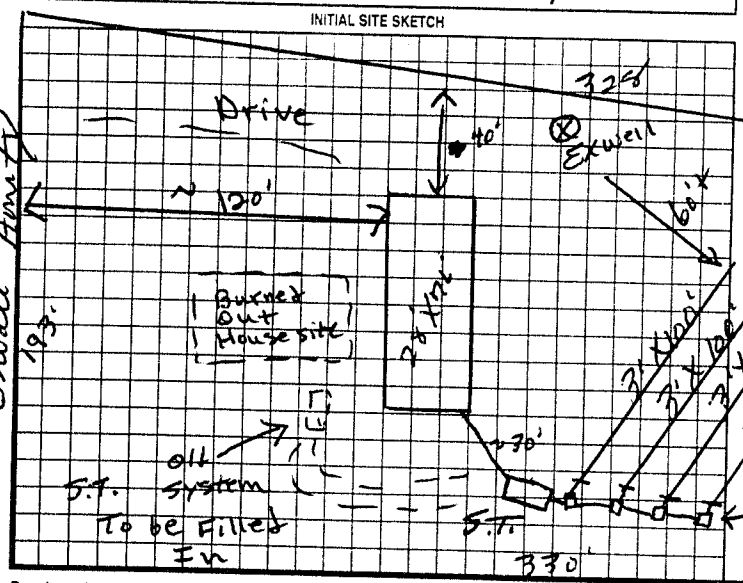

AS BUILT SKETCH

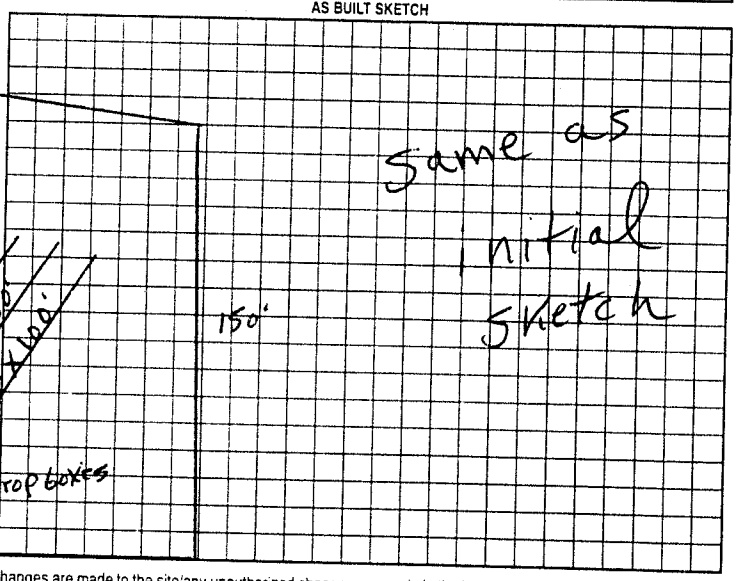

Permit can be suspended or revoked if any false information is supplied toward securing the permit/any unauthorized changes are made to the site/any unauthorized changes are made in the installation of the system. Improvement Permit with plat valid without expiration. Improvement Permit with site plan valid for sixty months. Authorization to Construct is valid for a period equal to that of Improvement Permit – not to exceed sixty months.

Signed: Thomas R Mahala date 11-23-99 Installed by: C + W Grading + Septic

Improvement Permit by: R. C. Moore date 11-22-99 Operation Permit by: R. C. Moore date 12-9-99

Authorization to Construct by: R. C. Moore date 11-22-99 Existing System Inspection by: _____ date _____

HEALTH DEPT. COPY: WHITE OWNER COPY (FINAL): YELLOW OWNER COPY (INITIAL): PINK